

SURVEY & REMONUMENTATION

FEB 14 1997

KENT COUNTY REMONUMENTATION

COMMISSION

LAND CORNER RECORDATION CERTIFICATE
Filing Requirement of Act 74, Mich. P.A. 1970

For corners in
KENT COUNTY

	Located In:	Corner Code #	
(County)	*		
1. Public Land Survey	T <u>6N</u> R <u>10W</u>	<u>J-5</u>	
	T <u> </u> R <u> </u>		
	T <u> </u> R <u> </u>		
	T <u> </u> R <u> </u>		
2. Property Controlling in Section	S <u> </u> T <u> </u> R <u> </u>		
	S <u> </u> T <u> </u> R <u> </u>		
3. Miscellaneous Property in Sec.	S <u> </u> T <u> </u> R <u> </u>		
	S <u> </u> T <u> </u> R <u> </u>		

4. Lot No. _____, Recorded Plat _____
5. Private Claims _____

I, Kirk Breitels, in a field survey on Feb. 12, 1996 do hereby state that under requirements of P.A. 74, Michigan P.A. of 1970, the corner points mentioned in lines 1 and 2 above were in conformance with regulations and rules therefore as required in the current manual of survey instructions of the United States Department of the Interior, Bureau of Land Management or by a decree of a Court of Law and/or that the corner points mentioned in lines 3, 4 and 5 above were in conformance with the rules of the Michigan Board of Land Surveyors or by a Decree of a Court of Law; established, re-established, monumented, recovered, found as expressed below:

NOTE: Not more than 2 corners, all in the same town and range, may be recorded on this certificate.

REG. OF DEEDS

8985

Register of Deeds Stamp & File Number

STATE OF MICHIGAN
COUNTY OF KENT
RECEIVED FOR RECORD

96 MAR 20 AM 8:47

Lucy Bond

A	B	C	D	E	F	G	H	I	J	K	L	M
2	6	5	4	3	2	1						
3												
4	7	8	9	10	11	12						
5												
6	18	17	16	15	14	13						
7												
8	19	20	21	22	23	24						
9												
10	30	29	28	27	26	25						
11												
12	31	32	33	34	35	36						
13												

A. Description of original monument and accessories and/or subsequent restoration:

J-5	1831	GLO	Mullett	Set Post	
		Kent Co. Wit.		Witnesses given	
	1979	LCRC #1267	Bonnema	1" Iron	
	1979	LCRC #1377	VanKooten	Iron	
	1982	LCRC #2744	Merdzinski	Set Kent County Monument	
	1991	LCRC #6083	Unema	Kent County Monument	

P.A. 345 1990 KENT COUNTY
PEER APPROVED 3/7/96
CHAIRMAN *Henry Huber*

The position of this corner was previously approved by the Kent County Remonumentation Peer Group, monumented by John A. Merdzinski on 2/18/82 and was recorded per LCRC #2744


B. Description of corner evidence found and/or method applied in restoring or reestablishing corner:
J-5 Found standard Kent Co. Mon. (Harrison) per witnesses from above LCRC as set by John A. Merdzinski in place of the 1" Iron he found. Said Iron checks with Kent Co. Wit. and LCRC's #1267, #1377.

<u>LCRC #2477</u>	<u>LCRC #6083</u>
Nail/tag Twin 8" Maple S45°E 10.45'	Nail/tag Twin 8" Maple S32°E 10.43'
Nail/tag 14" Oak S10°W 20.48'	Nail/tag 14" Oak S11°W 20.43'
Nail/tag 16" Hickory West 13.85'	Nail/tag 18" Hickory S85°W 13.78'
Nail/tag 12" Ash S45°W 33.70'	Nail/tag 12" Oak N37°W 7.51'
Nail/tag 12" Oak N35°W 7.54'	Nail/tag 14" Ash S32°W 33.61'

The selected location is accepted by me and is generally accepted by professional surveyors as the best available evidence of the position of the original corner.

C. Description of monument for corner and accessories established to perpetuate locating the position of the corner:

<u>J-5 Standard Kent County Monument</u>	
Nail & KC Remon. tag NW side Twin 10" Maple	S32°E 10.46'
Nail & KC Remon. tag E. side 16" Oak	S11°W 20.45'
New Nail & KC Remon. tag S. side 20" Hickory	S85°W 13.80'
Nail & KC Remon. tag E. side 14" Oak	N37°W 7.53'
Nail & KC Remon. tag NW side 16" Ash	S32°W 33.67'
On remains of fence E-W	
C/L 28th St. is South 100'±	

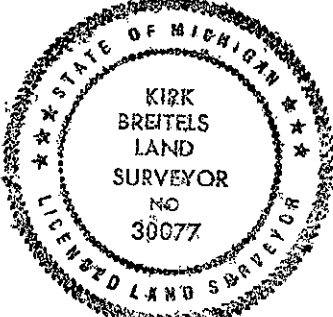

Signed by *Kirk Breitels*
Surveyor's Michigan License No. 30077

Date 3/1/96