

**SURVEY & REMONUMENTATION**

FEB 14 1997

KENT COUNTY REMONUMENTATION

**COMMISSION LAND CORNER RECORDATION CERTIFICATE**  
Filing Requirement of Act 74, Mich. P.A. 1970

For corners in

**KENT COUNTY**

(County)

Located In:

Corner Code #

1. Public Land Survey	T <u>6N</u> R <u>10W</u>	<u>J-6</u>
	T ___ R ___	_____
	T ___ R ___	_____
	T ___ R ___	_____
2. Property Controlling in Section	S ___ T ___ R ___	_____
	S ___ T ___ R ___	_____
3. Miscellaneous Property in Sec.	S ___ T ___ R ___	_____
	S ___ T ___ R ___	_____

REG. OF DEEDS  
STATE OF MICHIGAN  
COUNTY OF KENT  
RECEIVED FOR RECORD  
96 OCT 18 AM 8:19

9393

Register of Deeds Stamp & File Number

4. Lot No. \_\_\_\_\_, Recorded Plat \_\_\_\_\_  
5. Private Claims \_\_\_\_\_

I, Kirk Breitels, in a field survey on Sept. 27, 1996 do hereby state that under requirements of P.A. 74, Michigan P.A. of 1970, the corner points mentioned in lines 1 and 2 above were in conformance with regulations and rules therefore as required in the current manual of survey instructions of the United States Department of the Interior, Bureau of Land Management or by a decree of a Court of Law and /or that the corner points mentioned in lines 3, 4 and 5 above were in conformance with the rules of the Michigan Board of Land Surveyors or by a Decree of a Court of Law; established, re-established, monumented, recovered, found as expressed below:

NOTE: Not more than 2 corners, all in the same town and range, may be recorded on this certificate.

A	B	C	D	E	F	G	H	I	J	K	L	M
1												
2	6	5	4	3	2	1						
3												
4	7	8	9	10	11	12						
5												
6	18	17	16	15	14	13						
7												
8	19	20	21	22	23	24						
9												
10	30	29	28	27	26	25						
11												
12	31	32	33	34	35	36						
13												

A. Description of original monument and accessories and/or subsequent restoration:

- J-6 1831---GLO---Not Set
- 1956-65---Williams & Works---Set 1 1/2" Iron at intersection 1/4 lines  
40" Elm ENE 25.0' 12" Elm SE 26.25'  
18" Maple SW 36.85' 18" Maple W 54.90'
- 1985---LCRC #4271---G. Ward---3" Iron
- 1986---Survey---Byl---Int. of 1/4 line 2.6' N. of 3" Iron Pipe per LCRC #4271


B. Description of corner evidence found and/or method applied in restoring or reestablishing corner:

J-6 Found 3/4" Steel Bar at the intersection of 1/4 lines ± 0.2'. Established Intersection of 1/4 lines and found 1 1/2" Iron Pipe per LCRC #4271 to be 3.00' South of the Intersection of 1/4 lines.

The Intersection of 1/4 lines is accepted by me and is generally accepted by professional surveyors as the best available evidence of the position of the corner.

C. Description of monument for corner and accessories established to perpetuate locating the position of the corner:

- J-6 Set Standard Kent County Monument at the Intersection of 1/4 lines.  
(Removed 3/4" Steel Bar)
- Set Nail & KC Remon. tag S. side 18" Maple S90°W 4.44'
- Set Nail & KC Remon. tag E. side 18" Maple N05°W 9.15'
- Set Nail & KC Remon. tag SE side 20" Oak N45°E 35.12'
- Set Nail & KC Remon. tag N. side 24" Maple S90°E 4.15'
- Set Nail & KC Remon. tag NE side 24" Maple S50°E 36.97'

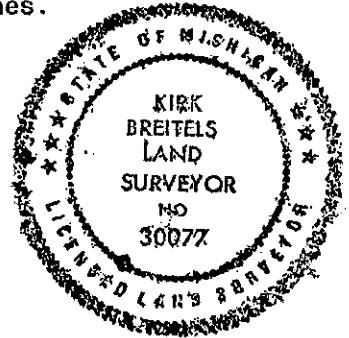

Signed by Kirk Breitels  
Surveyor's Michigan License No. 30077

Date 10/11/96

P.A. 345 1990 KENT COUNTY  
PEER APPROVED 9/26/96  
CHAIRMAN Harry Hubert