

FEB 14 1997

KENT COUNTY REMONUMENTATION

COMMISSION

LAND CORNER RECORDATION CERTIFICATE  
Filing Requirement of Act 74, Mich. P.A. 1970

For corners in

KENT COUNTY

(County)

Located In:

Corner Code #

1. Public Land Survey	T6N R 10W	J-7
	T R	
	T R	
	T R	
2. Property Controlling in Section	S T R	
	S T R	
3. Miscellaneous Property in Sec.	S T R	
	S T R	

STATE OF MICHIGAN  
COUNTY OF KENT  
RECEIVED FOR RECORD  
95 JUN -7 AM 8:27  
REG. OF DEEDS  
*David Spand*

9163

Register of Deeds Stamp & File Number

4. Lot No. \_\_\_\_\_, Recorded Plat \_\_\_\_\_  
5. Private Claims \_\_\_\_\_

I, Kirk Breitels, in a field survey on Apr. 3, 1996 do hereby state that under requirements of P.A. 74, Michigan P.A. of 1970, the corner points mentioned in lines 1 and 2 above were in conformance with regulations and rules therefore as required in the current manual of survey instructions of the United States Department of the Interior, Bureau of Land Management or by a decree of a Court of Law and/or that the corner points mentioned in lines 3, 4 and 5 above were in conformance with the rules of the Michigan Board of Land Surveyors or by a Decree of a Court of Law; established, re-established, monumented, recovered, found as expressed below:

A	B	C	D	E	F	G	H	I	J	K	L	M
1												
2	6	5	4	3	2	1						
3												
4	7	8	9	10	11	12						
5												
6	18	17	16	15	14	13						
7												
8	19	20	21	22	23	24						
9												
10	30	29	28	27	26	25						
11												
12	31	32	33	34	35	36						
13												

NOTE: Not more than 2 corners, all in the same town and range, may be recorded on this certificate.

A. Description of original monument and accessories and/or subsequent restoration:

P.A. 345 1990 KENT COUNTY

J-7	1831	GLO	Mullett	Set Post	PEER APPROVED <u>5/30/96</u>
	1956	Kent Co. Wit.		1/2" Iron	CHAIRMAN <i>Stan Huber</i>
	1978	LCRC #1237	Byl	Iron in Mon. Box	
	1982	LCRC #2745	Merdzinski	Set Kent County Monument in Mon. Box	
	1994	LCRC #6084	Bueche	Kent County Monument	

The position of this corner was previously approved by the Kent County Remonumentation Peer Group, monumented by John A. Merdzinski on 2/18/82 and was recorded per LCRC #2745

B. Description of corner evidence found and/or method applied in restoring or reestablishing corner:


J-7 Found standard Kent Co. Mon. (Harrison) per witnesses from above LCRC as set by John A. Merdzinski in place of the 5/8" Iron over a 1/2" Iron he found inside a Mon. Box. Both Irons check with Kent Co. Wit. and LCRC #1237.

<u>LCRC #2745 (Nail/tag in objects)</u>	<u>LCRC #6084</u>
30" Oak N05°W 52.78' 12" Elm N65°W 55.0'	NE cor. hse. fnd. S47°W 122.70'
MBT Pole N45°E 36.75'	Nail/tag 44" Oak N01°W 52.79'
10" Walnut S20°E 11.46'	Nail/tag MBT Pole N55°E 36.71'
P. Pole S20°W 77.12'	Nail/tag P. Pole S22°W 77.15'
NE hse. fnd. S45°W 122.75'	Nail/tag 12" Walnut S10°E 114.58'

The selected location is accepted by me and is generally accepted by professional surveyors as the best available evidence of the position of the original corner.

C. Description of monument for corner and accessories established to perpetuate locating the position of the corner:

J-7 Standard Kent County Monument	
NE corner house foundation	S47°W 122.70'
Nail & KC Remon. tag W. side 48" Oak	N01°W 52.81'
Nail & KC Remon. tag E. side MBT Pole	N55°E 36.75'
Nail & KC Remon. tag E. side P. Pole	S22°W 77.15'
Nail & KC Remon. tag E. side 14" Walnut	S10°E 114.58'
Mon. is in C/L roads E, W, & S.	
Mon. is on fence & tree line to N.	

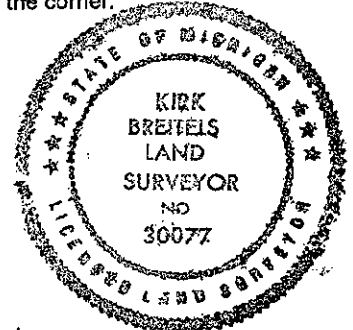

Signed by *Kirk Breitels*  
Surveyor's Michigan License No. 30077

Date 4/19/96