STATE OF MICHIGAN
COUNTY OF KENT
RECEIVED FOR RECORD
93 DEC 20 AM 11:57
REG. OF DEEDS

KENT COUNTY REMONUMENTATION

LAND CORNER RECORDATION CERTIFICATE

Filing Requirement of Act 74, Mich. P.A. 1970

For corners in Kent (County)

	Located In:	Corner Code ##
1. Public Land Survey	T 6N R 10W	J-8
	T ___ R ___	Center
	T ___ R ___	Section 23
	T ___ R ___	Cascade
2. Property Controlling	S ___ T ___ R ___	Township
in Section	S ___ T ___ R ___	
3. Miscellaneous	S ___ T ___ R ___	
Property in Sec.	S ___ T ___ R ___	

6859

Register of Deeds Stamp & File Number

4. Lot No. _____, Recorded Plat _____
5. Private Claims _____

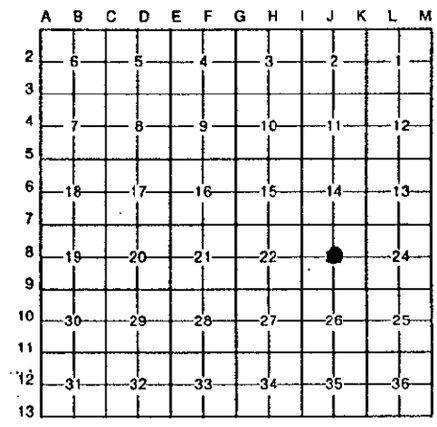

I, Thomas W. Chettleburgh, in a field survey on November 30, 19 93, do hereby certify that under requirements of P.A. 74, Michigan P.A. of 1970, the corner points mentioned in lines 1 and 2 above were in conformance with regulations and rules therefore as required in the current manual of survey instructions of the United States Department of the Interior, Bureau of Land Management or by a decree of a Court of Law and/or that the corner points mentioned in lines 3, 4 and 5 above were in conformance with the rules of the Michigan Board of Land Surveyors or by a Decree of a Court of Law; established, re-established, monumented, re-monumented, recovered, found as expressed below:

NOTE: Not more than 4 corners, all in the same town and range, may be recorded on this certificate.

A. Description of original monument and accessories and/or subsequent restoration:

W & W 1962, Found iron 1.25'W of N-S 1/4 line
MVK 1972, Found iron - record LCRC #428
Byl 1978, Found iron from LCRC #428 witnesses, record LCRC #1237
W & W 1983, Found iron 1.10'W of N-S 1/4 line

B. Description of corner evidence found and/or method applied in restoring or reestablishing corner:

Found iron - checked witnesses LCRC #428
Intersection of 1/4 lines 5.13'N & 0.83'E

Hold iron for corner

North 1/4 corner Section 23 (J-7)	N00°55'21"W	2657.59'
East 1/4 corner Section 23 (K-8)	N89°20'50"E	2674.97'
South 1/4 corner Section 23 (J-9)	S00°57'49"E	2634.28'
West 1/4 corner Section 23 (I-8)	S89°34'01"W	2665.84'

Replaced iron with 4"X30" Harrison Monument

C. Description of monument for corner and accessories established to perpetuate locating the position of the corner:

4"X30" Harrison Monument

Nail/tag	W side	17" Oak	N15°E	126.67'
Nail/tag	NW side	Power Pole	N33°E	69.36'
NW Corner	House Foundation		N62°E	100.67'
Nail/tag	S side	36" Oak	N90°E	23.04'
Nail/tag	W side	Power Pole	S09°E	108.10'
Nail/tag	E side	7" Elm	S11°W	151.02'
Nail/tag	N side	Power Pole	N87°W	41.46'

STATE OF MICHIGAN
THOMAS W. CHETTLEBURGH
LAND SURVEYOR NO. 16036
REGISTERED LAND SURVEYOR

Signed by Thomas W. Chettleburgh Date December 20, 1993

Surveyor's Michigan License No. 16036

FORM APPROVED BY MICHIGAN STATE BOARD OF LAND SURVEYORS, JAN. 28, 1971
REVISED MAY 14, 1975
REVISED JAN., 1983