

**SURVEY &  
REMONUMENTATION**

FEB 14 1997

KENT COUNTY REMONUMENTATION

**COMMISSION LAND CORNER RECORDATION CERTIFICATE**  
Filing Requirement of Act 74, Mich. P.A. 1970

For corners in  
**KENT COUNTY**

Located In:	Corner Code #
1. Public Land Survey T 6N R 10W	J-9
T R	
T R	
T R	
2. Property Controlling in Section S T R	
S T R	
3. Miscellaneous Property in Sec. S T R	
S T R	

STATE OF MICHIGAN  
COUNTY OF KENT  
RECEIVED FOR RECORD  
96 MAR 20 AM 8:47  
REG. OF DEEDS  
*Luigi Bond*


8986

Register of Deeds Stamp & File Number

4. Lot No. \_\_\_\_\_, Recorded Plat \_\_\_\_\_  
5. Private Claims \_\_\_\_\_

I, Kirk Breitels, in a field survey on Feb. 8, 1996 do hereby state that under requirements of P.A. 74, Michigan P.A. of 1970, the corner points mentioned in lines 1 and 2 above were in conformance with regulations and rules therefore as required in the current manual of survey instructions of the United States Department of the Interior, Bureau of Land Management or by a decree of a Court of Law and /or that the corner points mentioned in lines 3, 4 and 5 above were in conformance with the rules of the Michigan Board of Land Surveyors or by a Decree of a Court of Law; established, re-established, monumented, recovered, found as expressed below:

NOTE: Not more than 2 corners, all in the same town and range, may be recorded on this certificate.

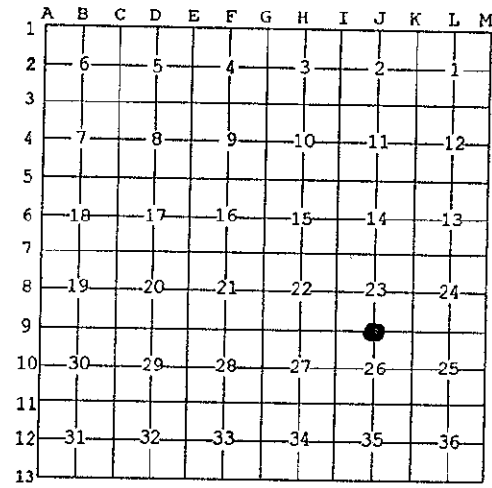

A. Description of original monument and accessories and/or subsequent restoration:

Date	LCRC #	Monument	Material
J-9 1831	GLO	Mullett	Set Post
1972	Kent Co. Wit.		PK Nail
1972	LCRC #270	VanKooten	1/2" Solid Iron
1972	LCRC #428	VanKooten	PK Nail
1981	LCRC #1628	Byl	Boat Spike
1982	LCRC #2746	Merdzinski	Set Kent County Monument
1991	LCRC #6085	Unema	Kent County Monument

P.A. 345 1990 KENT COUNTY  
PEER APPROVED 3/7/96  
CHAIRMAN *[Signature]*

The position of this corner was previously approved by the Kent County Remonumentation Peer Group, monumented by John A. Merdzinski on 3/26/82 and was recorded per LCRC #2746

B. Description of corner evidence found and/or method applied in restoring or reestablishing corner:

J-9 Found standard Kent Co. Mon. (Harrison) per witnesses from above LCRC as set by John A. Merdzinski in place of the Boat Spike he found. Said Boat Spike checks with Kent Co. Wit. and LCRC's #270, 428, 1628.

LCRC #2746	LCRC #6085
Nail/tag P. Pole S45°W 63.06'	Nail/tag 26" Maple S71°E 92.55'
Nail/tag 26" Oak S75°W 131.26'	Nail/tag 22" Hickory S23°E 83.73'
Nail/tag 20" Hickory S20°E 83.70'	Nail/tag top 15" CMP N70°W 74.96'
Nail/tag 22" Maple S70°E 92.55'	Nail/tag top 15" CMP N13°W 100.85'
Nail/tag Tw. Chin. Elm N25°E 141.35'	Nail/tag P. Pole S44°W 69.09'

The selected location is accepted by me and is generally accepted by professional surveyors as the best available evidence of the position of the original corner.

C. Description of monument for corner and accessories established to perpetuate locating the position of the corner:

Monument	Material	Distance
J-9 Standard Kent County Monument		
Nail & KC Remon. tag SW side 26" Maple	S71°E	92.60'
Nail & KC Remon. tag W. side 22" Hickory	S23°E	83.73'
PK Nail & KC Remon. tag top N. end 15" CMP	N70°W	74.96'
PK Nail & KC Remon. tag top W. end 15" CMP	N13°W	100.85'
Nail & KC Remon. tag SE side P. Pole	S44°W	63.09'
C/L E-W asph. rd. is 0.15'± S.		
C/L N-S asph. rd. is 1'± E.		



Signed by *Kirk Breitels*  
Surveyor's Michigan License No. 30077

Date 3/1/96