

KENT COUNTY REMONUMENTATION
LAND CORNER RECORDATION CERTIFICATE
Filing Requirement of Act 74, Mich. P.A. 1970

W. J. Bond
REG. OF DEEDS

6861

Register of Deeds Stamp & File Number

For corners in

Kent

(County)

Located In:


Corner Code #/

1. Public Land Survey	T <u>6N</u> R <u>10W</u>	J-10
	T _____ R _____	Center
	T _____ R _____	Section 26
	T _____ R _____	Cascade
2. Property Controlling in Section	S _____ T _____ R _____	Township
	S _____ T _____ R _____	
3. Miscellaneous Property in Sec.	S _____ T _____ R _____	
	S _____ T _____ R _____	

4. Lot No. _____, Recorded Plat _____
5. Private Claims _____

Thomas W.
Chettleburgh

I, Thomas W. Chettleburgh, in a field survey on November 30, 19 93 do hereby certify that under requirements of P.A. 74, Michigan P.A. of 1970, the corner points mentioned in lines 1 and 2 above were in conformance with regulations and rules therefore as required in the current manual of survey instructions of the United States Department of the Interior, Bureau of Land Management or by a decree of a Court of Law and/or that the corner points mentioned in lines 3, 4 and 5 above were in conformance with the rules of the Michigan Board of Land Surveyors or by a Decree of a Court of Law; established, re-established, monumented, re-monumented, recovered, found as expressed below:

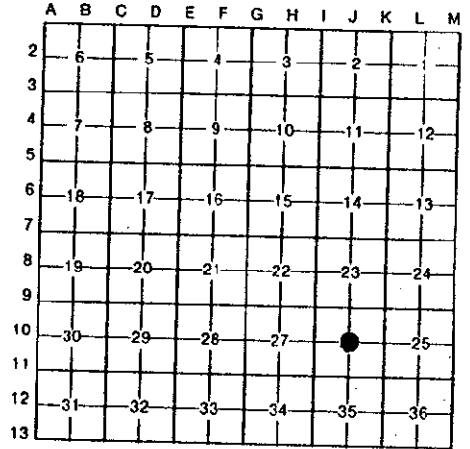


NOTE: Not more than 4 corners, all in the same town and range, may be recorded on this certificate.

A. Description of original monument and accessories and/or subsequent restoration:
W & W 1954, Held intersection of fences, found to be on E-W 1/4 line & 1.3'E of N-S 1/4 line
West 1/4 corner Section 26 2683.4'
East 1/4 corner Section 26 2642.8'
South 1/4 corner Section 26 2644.5'
Byl 1980, Found 1" iron, checked W & W section line measurements - record LCRC #1628

B. Description of corner evidence found and/or method applied in restoring or reestablishing corner:
Found 1" iron - checked witnesses LCRC #1628
Intersection of 1/4 lines 0.50°N & 12.67°W
Hold 1" iron for corner
North 1/4 corner Section 26 (J-9) N01°05'50"W 2657.52'
East 1/4 corner Section 26 (K-10) N89°19'22"E 2642.48'
South 1/4 corner Section 26 (J-11) S00°33'01"E 2644.49'
West 1/4 corner Section 26 (I-10) S89°21'04"W 2681.27'
Replaced 1" iron with 4"X30" Harrison Monument

Description of monument for corner and accessories established to perpetuate locating the position of the corner:
4"X30" Harrison Monument
Nail/tag SE side 8" Tw. Oak N60°E 40.22'
Nail/tag NE side 12" Tw. Elm S17°E 68.50'
Nail/tag NW side 13" Elm S32°W 51.43'
Nail/tag S side 21" Oak S87°W 63.08'
Nail/tag SW side 8" Elm N42°W 28.77'
E - W R.O.W. Fence Line I-96 North 1.0'

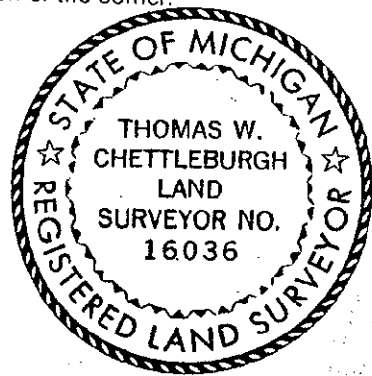

Witnessed by _____ Date December 20, 1993
Surveyor's Michigan License No. 16036