SURVEY & REMONUMENTATION

FEB 1 4 1997

COMMISSION

KENT COUNTY REMONUMENTATION

# LAND CORNER RECORDATION CERTIFICATE
Filing Requirement of Act 74, Mich. P.A. 1970

For corners in KENT COUNTY (County)

| | Located In: | Corner Code # |
|---|---|---|
| 1. Public Land Survey | T 6N R 10W | K-4 |
| | T___ R___ | |
| | T___ R___ | |
| | T___ R___ | |
| 2. Property Controlling | S___ T___ R___ | |
| in Section | S___ T___ R___ | |
| 3. Miscellaneous | S___ T___ R___ | |
| Property in Sec. | S___ T___ R___ | |

STATE OF MICHIGAN COUNTY OF KENT RECEIVED FOR RECORD 96 JUN -7 AM 8:27 REG. OF DEEDS

9164

Register of Deeds Stamp & File Number

4. Lot No. _____, Recorded Plat _____
5. Private Claims _____

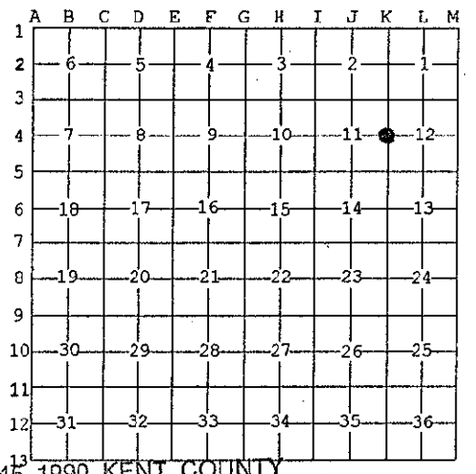


I, Kirk Breitels, in a field survey on Mar. 22, 19 96 do hereby state that under requirements of P.A. 74, Michigan P.A. of 1970, the corner points mentioned in lines 1 and 2 above were in conformance with regulations and rules therefore as required in the current manual of survey instructions of the United States Department of the Interior, Bureau of Land Management or by a decree of a Court of Law and /or that the corner points mentioned in lines 3, 4 and 5 above were in conformance with the rules of the Michigan Board of Land Surveyors or by a Decree of a Court of Law; established, re-established, monumented, recovered, found as expressed below:

NOTE: Not more than 2 corners, all in the same town and range, may be recorded on this certificate.

P.A. 345 1990 KENT COUNTY
PEER APPROVED 5/30/96
CHAIRMAN Harry Huber

A. Description of original monument and accessories and/or subsequent restoration:

| | | | | |
|---|---|---|---|---|
| K-4 | 1831 | GLO | Mullett | Set Post |
| | 1978 | LCRC #1110 | Bonnema | Set Iron on line with fence to North & East |
| | 1983 | LCRC #3213 | Stadt | Set Kent County Monument |
| | 1991 | LCRC #6095 | Unema | Kent County Monument |

The position of this corner was previously approved by the Kent County Remonumentation Peer Group, monumented by Russell E. Stadt on 3/17/83 and was recorded per LCRC #3213

B. Description of corner evidence found and/or method applied in restoring or reestablishing corner:

K-4 Found standard Kent Co. Mon. (Harrison) per witnesses from above LCRC as set by Russell E. Stadt in place of the 1" Iron he found. Said Iron checks with LCRC #1110.

| LCRC #3213 | | | LCRC #6095 | | |
|---|---|---|---|---|---|
| Nail/tag 14" Oak | N10°W | 45.85' | Nail/tag 16" Oak | N15°W | 45.80' |
| Nail/tag 10" Oak | N45°E | 23.40' | Nail/tag 12" Oak | N40°E | 23.52' |
| Nail/tag 18" Oak | S60°E | 24.80' | Nail/tag 20" Oak | S60°E | 24.84' |
| Nail/tag 10" Oak | S10°E | 32.45' | Nail/tag 12" Oak | S20°E | 32.48' |
| Nail/tag 12" Oak | S60°E | 44.40' | Nail/tag 14" Oak | S50°W | 44.42' |

The selected location is accepted by me and is generally accepted by professional surveyors as the best available evidence of the position of the original corner.

C. Description of monument for corner and accessories established to perpetuate locating the position of the corner:

K-4 Standard Kent County Monument

| | | | |
|---|---|---|---|
| Nail & KC Remon. tag W. side | 18" Oak | N15°W | 45.83' |
| Nail & KC Remon. tag NW side | 14" Oak | N40°E | 23.52' |
| Nail & KC Remon. tag SW side | 24" Oak | S60°E | 24.84' |
| Nail & KC Remon. tag W. side | 12" Oak | S20°E | 32.50' |
| Nail & KC Remon. tag SE side | 16" Oak | S50°W | 44.42' |

Mon. is on old fence lines ± to N & E

STATE OF MICHIGAN KIRK BREITELS LAND SURVEYOR NO 30077 LICENSED LAND SURVEYOR

Signed by Kirk Breitels Date 4/19/96

Surveyor's Michigan License No. 30077

FORM APPROVED BY MICHIGAN STATE BOARD OF PROFESSIONAL SURVEYORS, JAN. 28, 1971
REVISED MAY 14,1975
REVISED JAN., 1983
REVISED OCT., 1995