

FEB 14 1997

COMMISSION

**KENT COUNTY REMONUMENTATION**

**LAND CORNER RECORDATION CERTIFICATE**  
Filing Requirement of Act 74, Mich. P.A. 1970

For corners in

KENT COUNTY

(County)

Located In:

Corner Code #

1. Public Land Survey	T <u>6N</u> R <u>10W</u>	<u>K-6</u>
	T <u>   </u> R <u>   </u>	<u>   </u>
	T <u>   </u> R <u>   </u>	<u>   </u>
	T <u>   </u> R <u>   </u>	<u>   </u>
2. Property Controlling in Section	S <u>   </u> T <u>   </u> R <u>   </u>	<u>   </u>
	S <u>   </u> T <u>   </u> R <u>   </u>	<u>   </u>
3. Miscellaneous Property in Sec.	S <u>   </u> T <u>   </u> R <u>   </u>	<u>   </u>
	S <u>   </u> T <u>   </u> R <u>   </u>	<u>   </u>

STATE OF MICHIGAN  
COUNTY OF KENT  
RECEIVED FOR RECORD

96 JUN -7 AM 8:27

REG. OF DEEDS

*David Bond*

9165

Register of Deeds Stamp & File Number

4. Lot No. \_\_\_\_\_, Recorded Plat \_\_\_\_\_  
5. Private Claims \_\_\_\_\_

I, Kirk Breitels, in a field survey on Apr. 5, 19 96 do hereby state that under requirements of P.A. 74, Michigan P.A. of 1970, the corner points mentioned in lines 1 and 2 above were in conformance with regulations and rules therefore as required in the current manual of survey instructions of the United States Department of the Interior, Bureau of Land Management or by a decree of a Court of Law and/or that the corner points mentioned in lines 3, 4 and 5 above were in conformance with the rules of the Michigan Board of Land Surveyors or by a Decree of a Court of Law; established, re-established, monumented, recovered, found as expressed below:

A	B	C	D	E	F	G	H	I	J	K	L	M
1												
2	6	5	4	3	2	1						
3												
4	7	8	9	10	11	12						
5												
6	18	17	16	15	14	13						
7												
8	19	20	21	22	23	24						
9												
10	30	29	28	27	26	25						
11												
12	31	32	33	34	35	36						
13												

NOTE: Not more than 2 corners, all in the same town and range, may be recorded on this certificate.

A. Description of original monument and accessories and/or subsequent restoration:

K-6	1831	GLO	Mullett	Set Post
	1956	Kent Co. Wit.		Iron & Stone
	1978	LCRC #1381	Jonker	Iron
	1982	LCRC #2749	Merdzinski	Set Kent County Monument
	1991	LCRC #6097	Unema	Kent County Monument

P.A. 345 1990 KENT COUNTY  
PEER APPROVED 5/30/96  
CHAIRMAN *Hans Huber*

The position of this corner was previously approved by the Kent County Remonumentation Peer Group, monumented by John A. Merdzinski on 2/18/82 and was recorded per LCRC #2749

B. Description of corner evidence found and/or method applied in restoring or reestablishing corner:

K-6 Found BROKEN Kent Co. Mon. (Harrison). Reset Kent Co. Mon. (Harrison) per witnesses from above LCRC as set by John A. Merdzinski in place of the Iron and Stones he found. Said Iron and Stones check with Kent Co. Wit. and LCRC #1381.

<u>LCRC #2749</u>		<u>LCRC #6097</u>
Nail/tag 12" Oak	West 12.45'	Nail/tag 12" Oak West 12.51'
Nail/tag 12" Oak	N35°W 34.16'	Nail/tag 22" Oak South 0.41'
Nail/tag 6" Hickory	N45°E 14.95'	Nail/tag 14" Oak N35°W 34.20'
Nail/tag 14" Walnut	S85°E 48.34'	Nail/tag 8" Hickory N42°E 14.90'
Nail/tag 22" Oak	South 0.56'	Nail/tag 20" Walnut S80°E 48.22'


The selected location is accepted by me and is generally accepted by professional surveyors as the best available evidence of the position of the original corner.

C. Description of monument for corner and accessories established to perpetuate locating the position of the corner:

K-6 Standard Kent County Monument

Nail & KC Remon. tag E. side	16" Oak	N35°W	34.18'
Nail & KC Remon. tag NW side	10" Hickory	N42°E	14.93'
New Nail & KC Remon. tag N. side	22" Walnut	S80°E	48.24'
Set Nail & KC Remon. tag E. side	Tri. 24" Oak	S10°W	96.63'
Set Nail & KC Remon. tag NE side	10" Elm	S45°E	54.54'
Set Nail & KC Remon. tag N. side	15" Oak	West	18.92'

Mon. is at the North end of Quiggle Ave.

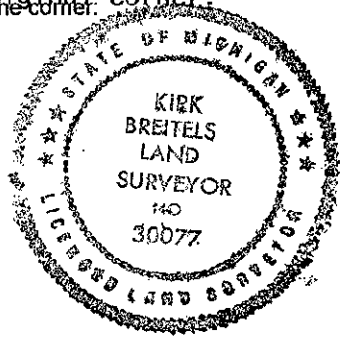

Signed by *Kirk Breitels*  
Surveyor's Michigan License No. 30077

Date 4/17/96