

SURVEY & REMONUMENTATION

FEB 14 1997

KENT COUNTY REMONUMENTATION

COMMISSION

LAND CORNER RECORDATION CERTIFICATE
Filing Requirement of Act 74, Mich. P.A. 1970

For corners in
KENT COUNTY

(County)

Located In:	Corner Code #
T 6N R 10W	K-7
T R	
T R	
T R	
S T R	
S T R	
S T R	
S T R	

- 1. Public Land Survey
- 2. Property Controlling in Section
- 3. Miscellaneous Property in Sec.

- 4. Lot No. _____, Recorded Plat _____
- 5. Private Claims _____

I, Kirk Breitels, in a field survey on Feb. 1, 1996 do hereby state that under requirements of P.A. 74, Michigan P.A. of 1970, the corner points mentioned in lines 1 and 2 above were in conformance with regulations and rules therefore as required in the current manual of survey instructions of the United States Department of the Interior, Bureau of Land Management or by a decree of a Court of Law and/or that the corner points mentioned in lines 3, 4 and 5 above were in conformance with the rules of the Michigan Board of Land Surveyors or by a Decree of a Court of Law; established, re-established, monumented, recovered, found as expressed below:

NOTE: Not more than 2 corners, all in the same town and range, may be recorded on this certificate.

A	B	C	D	E	F	G	H	I	J	K	L	M
1												
2	6	5	4	3	2	1						
3												
4	7	8	9	10	11	12						
5												
6	18	17	16	15	14	13						
7												
8	19	20	21	22	23	24						
9												
10	30	29	28	27	26	25						
11												
12	31	32	33	34	35	36						
13												

STATE OF MICHIGAN
 COUNTY OF KENT
 RECEIVED FOR RECORD
 96 MAR 20 AM 8:47
 REG. OF DEEDS
W. J. Bond

8992

Register of Deeds Stamp & File Number

A. Description of original monument and accessories and/or subsequent restoration:

K-7	1831	GLO	Mullett	Set Post
	1964	Kent Co. Wit.		Iron
	1971	LCRC #43	Chambers	1/2" Iron
	1978	LCRC #1309	Jonker	1" Iron
	1981	LCRC #1601	Merdzinski	Set Kent County Monument
	1991	LCRC #6098	Unema	Kent County Monument

P.A. 345 1990 KENT COUNTY
 PEER APPROVED 3/7/96
 CHAIRMAN *Harry Nubee*

The position of this corner was previously approved by the Kent County Remonumentation Peer Group, monumented by John A. Merdzinski on 2/17/81 and was recorded per LCRC #1601

B. Description of corner evidence found and/or method applied in restoring or reestablishing corner:

K-7 Found standard Kent Co. Mon. (Harrison) per witnesses from above LCRC as set by John A. Merdzinski in place of the 1/2" Iron he found. Said Iron checks with Kent Co. Wit. and LCRC's #43, #1309.


<u>LCRC #1601</u>	<u>LCRC #6098</u>
Nail/tag T. Pole S60°E 58.84'	Nail/tag 12" Elm N77°W 142.19'
Nail/tag P. Pole S30°E 61.93'	Nail/tag P&T Pole S40°W 67.52'
Nail/tag P. Pole S40°W 67.49'	Nail/tag P&T Pole S33°E 61.92'
Nail/tag 6" stump N70°W 76.31'	C/L top MBT Box N54°W 59.10'
C/L str. sign N40°W 32.10'	C/L str. sign post N24°W 41.45'

The selected location is accepted by me and is generally accepted by professional surveyors as the best available evidence of the position of the original corner.

C. Description of monument for corner and accessories established to perpetuate locating the position of the corner:

K-7 Standard Kent County Monument

Nail & KC Remon. tag N. side 14" Elm	N77°W	142.19'
Nail & KC Remon. tag SE side P & T Pole	S40°W	67.52'
Nail & KC Remon. tag NE side P & T Pole	S33°E	61.92'
C/L top of 4' x 4' MBT Box	N54°W	59.10'
C/L street sign post	N24°W	41.45'
C/L E-W road is 4' ± South		
C/L N-S road is 1.5' ± West		

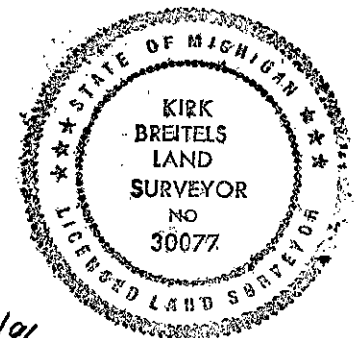

Signed by *Kirk Breitels*
 Surveyor's Michigan License No. 30077

Date 3/1/96