

**SURVEY & REMONUMENTATION**

FEB 14 1997

**COMMISSION**

**KENT COUNTY REMONUMENTATION**

**LAND CORNER RECORDATION CERTIFICATE**  
Filing Requirement of Act 74, Mich. P.A. 1970

For corners in

KENT COUNTY

(County)

Located in:

Corner Code #

1. Public Land Survey	T <u>6N</u> R <u>10W</u>	<u>K-10</u>
	T <u>   </u> R <u>   </u>	<u>   </u>
	T <u>   </u> R <u>   </u>	<u>   </u>
	T <u>   </u> R <u>   </u>	<u>   </u>
2. Property Controlling in Section	S <u>   </u> T <u>   </u> R <u>   </u>	<u>   </u>
	S <u>   </u> T <u>   </u> R <u>   </u>	<u>   </u>
3. Miscellaneous Property in Sec.	S <u>   </u> T <u>   </u> R <u>   </u>	<u>   </u>
	S <u>   </u> T <u>   </u> R <u>   </u>	<u>   </u>

STATE OF MICHIGAN  
COUNTY OF KENT  
RECEIVED FOR RECORD

95 JUN -7 AM 8:27

REG. OF DEEDS

**9167**

Register of Deeds Stamp & File Number

4. Lot No. \_\_\_\_\_, Recorded Plat \_\_\_\_\_  
5. Private Claims \_\_\_\_\_

I, Kirk Breitels, in a field survey on Apr. 2, 1996 do hereby state that under requirements of P.A. 74, Michigan P.A. of 1970, the corner points mentioned in lines 1 and 2 above were in conformance with regulations and rules therefore as required in the current manual of survey instructions of the United States Department of the Interior, Bureau of Land Management or by a decree of a Court of Law and /or that the corner points mentioned in lines 3, 4 and 5 above were in conformance with the rules of the Michigan Board of Land Surveyors or by a Decree of a Court of Law; established, re-established, monumented, recovered, found as expressed below:

NOTE: Not more than 2 corners, all in the same town and range, may be recorded on this certificate.

A	B	C	D	E	F	G	H	I	J	K	L	M
1												
2	6	5	4	3	2	1						
3												
4	7	8	9	10	11	12						
5												
6	18	17	16	15	14	13						
7												
8	19	20	21	22	23	24						
9												
10	30	29	28	27	26	25						
11												
12	31	32	33	34	35	36						
13												

A. Description of original monument and accessories and/or subsequent restoration:

K-10	1831	GLO	Mullett	Set Post
		Kent Co. Wit.		1/2" Iron
	1983	LCRC #3698	Jonker	Set Kent County Monument
	1991	LCRC #6101	Unema	Kent County Monument

P.A. 315 1900 KENT COUNTY

PEER APPROVED 5/30/96  
CHAIRMAN [Signature]

The position of this corner was previously approved by the Kent County Remonumentation Peer Group, monumented by Robert J. Jonker on 4/20/83 and was recorded per LCRC #3698

B. Description of corner evidence found and/or method applied in restoring or reestablishing corner:


K-10 Found standard Kent Co. Mon. (Harrison) per wit. from above LCRC as set by Robert J. Jonker in place of the "T" Iron he found. Said "T" Iron checks with Kent Co. Wit. LCRC #3698

NE cor. steel fc. post	N85°W	55.15'	NE cor. top steel fc. post	N88°W	55.43'
NW cor. steel fc. post	N85°E	55.51'	NW cor. top steel fc. post	N88°E	55.42'
C/L top conc. R/W marker	S20°E	115.74'	C/L top conc. R/W marker	S15°E	115.81'
C/L E. bd. const. joint	North	94.3'	C/L E. bound const. joint	North	94.34'
			Nail/tag 12" Walnut	S72°E	27.76'
			Nail/tag 8" Elm	S82°W	13.32'

The selected location is accepted by me and is generally accepted by professional surveyors as the best available evidence of the position of the original corner.

C. Description of monument for corner and accessories established to perpetuate locating the position of the corner:

K-10 Standard Kent County Monument	
NE cor. top steel fence post	N88°W 55.43'
NW cor. top steel fence post	N88°E 55.42'
C/L top of conc. R/W marker	S15°E 115.81'
C/L E. bound const. joint (I-96)	North 94.34'
Nail & KC Remon. tag NE side 14" Walnut	S72°E 27.76'
New Nail & KC Remon. tag S. side 12" Elm	S82°W 13.29'
Set Nail & KC Remon. tag E. side 24" Maple	S15°W 130.58'
E-W Hwy. R/W fence is North 5'±	
N. edge grav. turnaround is South 15'±	

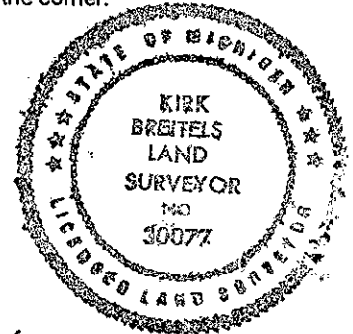

Signed by [Signature]  
Surveyor's Michigan License No. 30077

Date 4/19/96