

SURVEY & MONUMENTATION

FEB 14 1997

COMMISSION

KENT COUNTY REMONUMENTATION

LAND CORNER RECORDATION CERTIFICATE
Filing Requirement of Act 74, Mich. P.A. 1970

For corners in
KENT COUNTY

(County).

Located In: Corner Code #

1. Public Land Survey	T6N R 10W	K-13
	T R	
	T R	
	T R	
2. Property Controlling In Section	S T R	
	S T R	
3. Miscellaneous Property in Sec.	S T R	
	S T R	

STATE OF MICHIGAN
COUNTY OF KENT
RECEIVED FOR RECORD

96 JUN -7 AM 8:27

REG. OF DEEDS

W. J. ...

9168

Register of Deeds Stamp & File Number

4. Lot No. _____, Recorded Plat _____
5. Private Claims _____

I, Kirk Breitels, in a field survey on Apr. 3, 1996 do hereby state that under requirements of P.A. 74, Michigan P.A. of 1970, the corner points mentioned in lines 1 and 2 above were in conformance with regulations and rules therefore as required in the current manual of survey instructions of the United States Department of the Interior, Bureau of Land Management or by a decree of a Court of Law and /or that the corner points mentioned in lines 3, 4 and 5 above were in conformance with the rules of the Michigan Board of Land Surveyors or by a Decree of a Court of Law; established, re-established, monumented, recovered, found as expressed below:

NOTE: Not more than 2 corners, all in the same town and range, may be recorded on this certificate.

A	B	C	D	E	F	G	H	I	J	K	L	M
1												
2	6	5	4	3	2	1						
3												
4	7	8	9	10	11	12						
5												
6	18	17	16	15	14	13						
7												
8	19	20	21	22	23	24						
9												
10	30	29	28	27	26	25						
11												
12	31	32	33	34	35	36						
13												

A. Description of original monument and accessories and/or subsequent restoration:

K-13	1831	GLO	Mullett	Set Post
	1968	Kent Co. Wit.		3/4" Iron
	1984	LCRC #3818	Chettleburgh	Set Kent County Monument
	1991	LCRC #6104	Unema	Kent County Monument

P.A. 345 1990 KENT COUNTY
PEER APPROVED 5/30/96
CHAIRMAN *Thomas Chettleburgh*

The position of this corner was previously approved by the Kent County Remonumentation Peer Group, monumented by Thomas Chettleburgh on 12/29/83 and recorded per LCRC #3818

B. Description of corner evidence found and/or method applied in restoring or reestablishing corner:


K-13 Found standard Kent Co. Mon. (Harrison) per witnesses from above LCRC as set by Thomas Chettleburgh in place of the Iron Pipe he found. Said Iron Pipe checks with Kent Co. Wit. and survey work of others

<u>LCRC #3818</u>		<u>LCRC #6104</u>
Nail in P. Pole	N02°E 66.78'	Nail/tag 34" Maple N39°E 39.40'
Nail in 31" Maple	N38°E 39.55'	Nail/tag 20" Maple S57°E 46.25'
Nail in 20" Maple	S58°E 46.34'	Nail/tag 30" Oak S65°W 38.88'
Nail in 29" Oak	S65°W 38.87'	Nail/tag 18" Oak N48°W 48.75'
Nail in 17" Oak	N49°W 48.74'	Nail/tag P. Pole N04°E 66.77'

The selected location is accepted by me and is generally accepted by professional surveyors as the best available evidence of the position of the original corner.

C. Description of monument for corner and accessories established to perpetuate locating the position of the corner:

K-13 Standard Kent County Monument			
Nail & KC Remon. tag SE side	36" Maple	N39°E	39.45'
Nail & KC Remon. tag NW side	32" Oak	S65°W	38.88'
Nail & KC Remon. tag SW side	20" Oak	N48°W	48.75'
Nail & KC Remon. tag W. side	P. Pole	N04°E	66.81'
KC Mon. (NE cor. Sec. 2-5-10)		West	30.42'
C/L 60th St. is South	4.4'±		

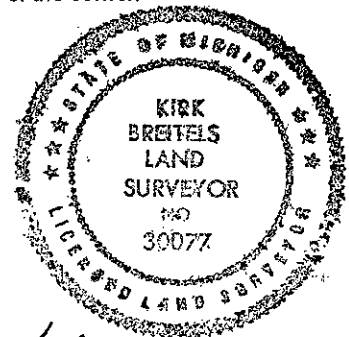

Signed by *Kirk Breitels*
Surveyor's Michigan License No. 30077

Date 4/19/96