

YV  
 SURVEY &  
 REMONUMENTATION

FEB 14 1997

KENT COUNTY REMONUMENTATION

COMMISSIONER

LAND CORNER RECORDATION CERTIFICATE  
 Filing Requirement of Act 74, Mich. P.A. 1970

For corners in

KENT COUNTY

(County)

Located in:

Corner Code #

1. Public Land Survey	T 6N R 10W	L-3
	T R	
	T R	
	T R	
2. Property Controlling in Section	S T R	
	S T R	
3. Miscellaneous Property in Sec.	S T R	
	S T R	

STATE OF MICHIGAN  
 COUNTY OF KENT  
 RECEIVED FOR RECORD

96 JUN -7 AM 8:28

REG. OF DEEDS  
*W. J. Bond*

9169

Register of Deeds Stamp & File Number

4. Lot No. \_\_\_\_\_, Recorded Plat \_\_\_\_\_  
 5. Private Claims \_\_\_\_\_

I, Kirk Breitels, in a field survey on Mar. 29, 1996 do hereby state that under requirements of P.A. 74, Michigan P.A. of 1970, the corner points mentioned in lines 1 and 2 above were in conformance with regulations and rules therefore as required in the current manual of survey instructions of the United States Department of the Interior, Bureau of Land Management or by a decree of a Court of Law and for that the corner points mentioned in lines 3, 4 and 5 above were in conformance with the rules of the Michigan Board of Land Surveyors or by a Decree of a Court of Law, established, re-established, monumented, recovered, found as expressed below:

NOTE: Not more than 2 corners, all in the same town and range, may be recorded on this certificate.

A	B	C	D	E	F	G	H	I	J	K	L	M
1												
2	6	5	4	3	2	1						
3												
4	7	8	9	10	11	12						
5												
6	18	17	16	15	14	13						
7												
8	19	20	21	22	23	24						
9												
10	30	29	28	27	26	25						
11												
12	31	32	33	34	35	36						
13												

A. Description of original monument and accessories and/or subsequent restoration:

L-3	1831	GLO	Mullett	Set Post
		Kent Co. Wit.		Iron
	1984	LCRC #3711	Chettleburgh	Set Kent County Monument at prorated dim.
				with Exxel survey in line with fence to West
	1991	LCRC #6053	Unema	Kent County Monument

P.A. 345 1990 KENT COUNTY

PEER APPROVED 5/30/96  
 CHAIRMAN Harry Hubbell

The position of this corner was previously approved by the Kent County Remonumentation Peer Group, monumented by Thomas Chettleburgh on 1/5/84 and was recorded per LCRC #3711

B. Description of corner evidence found and/or method applied in restoring or reestablishing corner:


L-3 Found standard Kent Co. Mon. (Harrison) per witnesses from above LCRC as set by Thomas Chettleburgh at location he described.

<u>LCRC #3711</u>	<u>LCRC #6053</u>
Nail/tag Tw. 15" Oak S03°E 171.23'	Nail/tag Twin 24" Ash S18°W 145.26'
Nail/tag Tw. 20" Ash S18°W 145.29'	Nail/tag 20" Ash S49°W 161.62'
Nail/tag 15" Ash S49°W 161.54'	Nail/tag Twin 18" Oak S02°E 171.20'
Nail/tag 23" Oak S80°W 160.84'	Nail/tag 20" Oak N21°W 155.83'
Nail/tag Tw. 24" Elm N61°W 123.47'	Nail/tag Twin 26" Maple N60°W 123.43'
Nail/tag 18" Oak N22°W 155.78'	S. bank of Grand River N00°E 150'±

The selected location is accepted by me and is generally accepted by professional surveyors as the best available evidence of the position of the original corner

C. Description of monument for corner and accessories established to perpetuate locating the position of the corner:

L-3 Standard Kent County Monument	
New Nail & KC Remon. tag E. side Twin 26" Ash	S18°W 145.22'
New Nail & KC Remon. tag SE side 22" Ash	S49°W 161.64'
New Nail & KC Remon. tag E. side Twin 20" Oak	S02°E 171.18'
New Nail & KC Remon. tag E. side 22" Oak	N21°W 155.83'
New Nail & KC Remon. tag N. side Twin 28" Maple	N60°W 123.39'
S. bank of Grand River	N00°E 150'±
Mon. is in clearing - pasture	

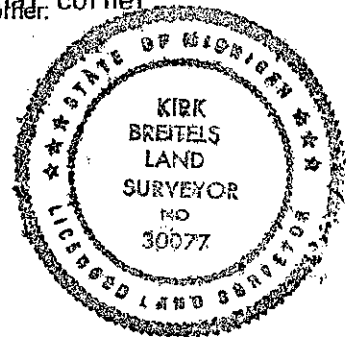

Signed by Kirk Breitels  
 Surveyor's Michigan License No. 30077

Date 4/19/96