

FEB 14 1997

COMMISSION

KENT COUNTY REMONUMENTATION

LAND CORNER RECORDATION CERTIFICATE
Filing Requirement of Act 74, Mich. P.A. 1970

For corners in

KENT COUNTY

(County)

Located in:

Corner Code #

1. Public Land Survey	T <u>6N</u> R <u>10W</u>	<u>L-8</u>
	T ___ R ___	_____
	T ___ R ___	_____
	T ___ R ___	_____
2. Property Controlling in Section	S ___ T ___ R ___	_____
	S ___ T ___ R ___	_____
3. Miscellaneous Property in Sec.	S ___ T ___ R ___	_____
	S ___ T ___ R ___	_____

STATE OF MICHIGAN
COUNTY OF KENT
RECEIVED FOR RECORD

96 JUN -7 AM 8:28

REG. OF DEEDS

Lucy Stand

9170

Register of Deeds Stamp & File Number

4. Lot No. _____, Recorded Plat _____
5. Private Claims _____

I, Kirk Breitels, in a field survey on Apr. 3, 19 96 do hereby state that under requirements of P.A. 74, Michigan P.A. of 1970, the corner points mentioned in lines 1 and 2 above were in conformance with regulations and rules therefore as required in the current manual of survey instructions of the United States Department of the Interior, Bureau of Land Management or by a decree of a Court of Law and/or that the corner points mentioned in lines 3, 4 and 5 above were in conformance with the rules of the Michigan Board of Land Surveyors or by a Decree of a Court of Law; established, re-established, monumented, recovered, found as expressed below:

NOTE: Not more than 2 corners, all in the same town and range, may be recorded on this certificate.

A	B	C	D	E	F	G	H	I	J	K	L	M
1												
2	6		5		4		3		2		1	
3												
4	7		8		9		10		11		12	
5												
6	10		17		16		15		14		13	
7												
8	19		20		21		22		23		24	
9												
10	30		29		28		27		26		25	
11												
12	31		32		33		34		35		36	
13												

A. Description of original monument and accessories and/or subsequent restoration:

L-8	1831	GLO	Mullett	Not Set
	1946	Williams & Works		Fence Corner
	1977	Medema & Vankooten		"X" 1/4 lines (not set)
	1991	LCRC #5767	Chettleburgh	Set Kent County Monument at intersection of 1/4 lines

P.A. 345 1990 KENT COUNTY
PEER APPROVED 5/30/96
CHAIRMAN *Harry Hubert*

The position of this corner was previously approved by the Kent County Remonumentation Peer Group, monumented by Thomas Chettleburgh on 5/21/90 and recorded per LCRC #5767

B. Description of corner evidence found and/or method applied in restoring or reestablishing corner:

L-8 Found standard Kent Co. Mon. (Harrison) per witnesses from above LCRC as set by Thomas Chettleburgh at the location he described.
LCRC #5767


Nail & KC Remon. tag N. side	35" Ash	S68°E	38.48'
Nail & KC Remon. tag NE side	25" Oak	S12°E	31.34'
Nail & KC Remon. tag W. side	13" Ash	S05°W	18.77'
Nail & KC Remon. tag N. side	15" Basswood	S75°W	27.49'
Nail & KC Remon. tag NE side	11" Basswood	N76°W	67.30'

The selected location is accepted by me and is generally accepted by professional surveyors as the best available evidence of the position of the corner.

C. Description of monument for corner and accessories established to perpetuate locating the position of the corner:

L-8 Standard Kent County Monument

Nail & KC Remon. tag N. side	38" Ash	S68°E	38.51'
New Nail & KC Remon. tag NE side	27" Oak	S12°E	31.32'
Nail & KC Remon. tag W. side	16" Ash	S05°W	18.80'
Nail & KC Remon. tag N. side	18" Basswood	S75°W	27.51'
Nail & KC Remon. tag NE side	14" Basswood	N76°W	67.33'

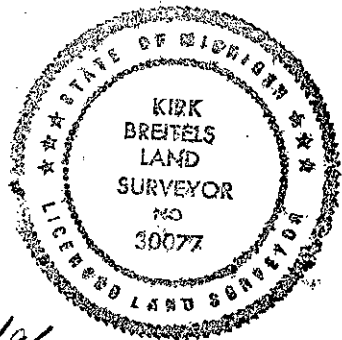

Signed by *Kirk Breitels*
Surveyor's Michigan License No. 30077

Date 4/19/96