

KENT COUNTY REMONUMENTATION  
LAND CORNER RECORDATION CERTIFICATE  
Filing Requirement of Act 74, Mich. P.A. 1970

STATE OF MICHIGAN  
COUNTY OF KENT  
RECEIVED FOR RECORD  
93 DEC 20 AM 11:57

*David J. Bond*  
REG. OF DEEDS

6860

Register of Deeds Stamp & File Number

For corners in	Located In:	Corner Code #
<u>Kent</u> <small>(County)</small>		
1. Public Land Survey	T <u>6N</u> R <u>10W</u>	<u>L-10</u>
	T _____ R _____	<u>Center</u>
	T _____ R _____	<u>Section 25</u>
	T _____ R _____	<u>Cascade</u>
2. Property Controlling in Section	S _____ T _____ R _____	<u>Township</u>
	S _____ T _____ R _____	
3. Miscellaneous Property in Sec.	S _____ T _____ R _____	
	S _____ T _____ R _____	

- 4. Lot No. \_\_\_\_\_, Recorded Plat \_\_\_\_\_
- 5. Private Claims \_\_\_\_\_

Thomas W.

I, Chettleburgh, in a field survey on November 30, 1993, do hereby certify that under requirements of P.A. 74, Michigan P.A. of 1970, the corner points mentioned in lines 1 and 2 above were in conformance with regulations and rules therefore as required in the current manual of survey instructions of the United States Department of the Interior, Bureau of Land Management or by a decree of a Court of Law and/or that the corner points mentioned in lines 3, 4 and 5 above were in conformance with the rules of the Michigan Board of Land Surveyors or by a Decree of a Court of Law; established, re-established, monumented, re-monumented, recovered, found as expressed below:

NOTE: Not more than 4 corners, all in the same town and range, may be recorded on this certificate.

	A	B	C	D	E	F	G	H	I	J	K	L	M
2	6	5	4	3	2	1							
3													
4	7	8	9	10	11	12							
5													
6	18	17	16	15	14	13							
7													
8	19	20	21	22	23	24							
9													
10	30	29	28	27	26	25							
11													
12	31	32	33	34	35	36							
13													

A. Description of original monument and accessories and/or subsequent restoration:


No record of corner during research  
Exxel holding intersection of 1/4 lines for surveys in NE 1/4  
MVK holding intersection of 1/4 lines for surveys in NW 1/4

B. Description of corner evidence found and/or method applied in restoring or reestablishing corner:

Hold intersection of 1/4 lines for corner  
North 1/4 corner of Section 25 (L-9) N00°47'24"W 2649.09'  
East 1/4 corner of Section 25 (M-10) N89°50'09"E 2643.50'  
South 1/4 corner of Section 25 (L-11) S00°47'24"E 2635.86'  
West 1/4 corner of Section 25 (K-10) S89°50'09"W 2637.88'  
Set 4"X30" Harrison Monument at intersection of 1/4 lines

C. Description of monument for corner and accessories established to perpetuate locating the position of the corner:

4"X30" Harrison Monument  
Nail/Tag S side 4" Triple Elm N70°E 12.68'  
Nail/Tag S side 4" Elm N83°E 19.38'  
Nail/Tag S side 4" Elm N88°W 53.21'  
Nail/Tag N side 6" Elm N84°W 59.55'  
E - W R.O.W. Fence Line I-96 North 5.70'

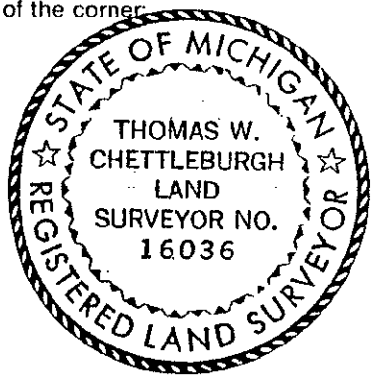

Signed by Thomas W. Chettleburgh Date December 20, 1993  
Surveyor's Michigan License No. 16036