

FEB 14 1997

KENT COUNTY REMONUMENTATION

COMMISSION LAND CORNER RECORDATION CERTIFICATE  
Filing Requirement of Act 74, Mich. P.A. 1970

For corners in  
KENT COUNTY

Located In:	Corner Code #
T 6N R 10W	M-1
T 6N R 9W	A-1
T 7N R 10W	M-13
T 7N R 9W	A-13
S ___ T ___ R ___	___
S ___ T ___ R ___	___
S ___ T ___ R ___	___
S ___ T ___ R ___	___

1. Public Land Survey

2. Property Controlling in Section

3. Miscellaneous Property in Sec.

4. Lot No. \_\_\_\_\_, Recorded Plat \_\_\_\_\_  
5. Private Claims \_\_\_\_\_

STATE OF MICHIGAN  
COUNTY OF KENT  
RECEIVED FOR RECORD

96 JUN -7 AM 8:28

REG. OF DEEDS

9171

Register of Deeds Stamp & File Number

I, Kirk Breitels, in a field survey on Mar. 21, 1996 do hereby state that under requirements of P.A. 74, Michigan P.A. of 1970, the corner points mentioned in lines 1 and 2 above were in conformance with regulations and rules therefore as required in the current manual of survey instructions of the United States Department of the Interior, Bureau of Land Management or by a decree of a Court of Law and for that the corner points mentioned in lines 3, 4 and 5 above were in conformance with the rules of the Michigan Board of Land Surveyors or by a Decree of a Court of Law; established, re-established, monumented, recovered, found as expressed below:

NOTE: Not more than 2 corners, all in the same town and range, may be recorded on this certificate.

	A	B	C	D	E	F	G	H	I	J	K	L	M
1													
2	6	5	4	3	2	1							
3													
4	7	8	9	10	11	12							
5													
6	18	17	16	15	14	13							
7													
8	19	20	21	22	23	24							
9													
10	30	29	28	27	26	25							
11													
12	31	32	33	34	35	36							
13													

A. Description of original monument and accessories and/or subsequent restoration:

Date	Monument	Location	Material
M-1 1831	GLO	Mullett	Set Post
1963	Kent Co. Wit.		Stone
1974	LCRC #773	Nederveld	Iron
1975	LCRC #917	McCombs	3/4" Pipe
1981	LCRC #1763	Merdzinski	Set Kent County Monument
1991	LCRC #5829	Unema	Kent County Monument

P.A. 345 1990 KENT COUNTY  
PEER APPROVED 5/30/96  
CHAIRMAN [Signature]

The position of this corner was previously approved by the Kent County Remonumentation Peer Group, monumented by John A. Merdzinski on 1/28/81 and was recorded per LCRC #1763

B. Description of corner evidence found and/or method applied in restoring or reestablishing corner:

M-1 Found standard Kent Co. Mon. (Harrison) per witnesses from above LCRC as set by John A. Merdzinski in place of the 3/4" Iron Pipe over Stone he found. Said Iron and Stone checks with Kent Co. Wit. and LCRC's #773 & #917  
LCRC #1763 (Nail/tag in trees)      LCRC #5829


24" Oak N45°E 42.88'	6" Oak N25°E 34.63'	Nail/tag 10" Oak N22°E 34.52'
14" Twin Cherry N20°W 42.28'		Nail/tag 28" Oak N45°E 43.23'
6" Oak N60°W 21.05'		Nail/tag 26" Oak S47°W 54.40'
12" Oak S00°E 43.44'		Nail/tag 12" Oak S00°W 43.38'
24" Oak S45°E 54.48'		Nail/tag 10" Oak S53°W 20.91'

The selected location is accepted by me and is generally accepted by professional surveyors as the best available evidence of the position of the original corner.

C. Description of monument for corner and accessories established to perpetuate locating the position of the corner.

M-1 Standard Kent County Monument

Nail & KC Remon. tag E. side	12" Oak N22°E	34.52'
Nail & KC Remon. tag SE side	28" Oak N45°E	43.20'
Nail & KC Remon. tag SW side	28" Oak S47°E	54.42'
Nail & KC Remon. tag W. side	14" Oak S00°W	43.34'
Nail & KC Remon. tag SE side	12" Oak S53°W	20.88'
3'± South of grav. rd. East		
On C/L trail to North ±		

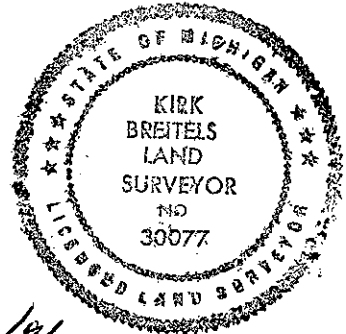

Signed by [Signature]  
Surveyor's Michigan License No. 30077

Date 4/19/96