

**SURVEY & REMONUMENTATION**

FEB 14 1997

**COMMISSION**

**KENT COUNTY REMONUMENTATION**

**LAND CORNER RECORDATION CERTIFICATE**  
Filing Requirement of Act 74, Mich. P.A. 1970

For corners in  
**KENT COUNTY**

(County)

Located In:

Corner Code #

1. Public Land Survey

T 6N	R 10W	M-2
T 6N	R 9W	A-2
T	R	
T	R	
S	T	R
S	T	R
S	T	R
S	T	R

2. Property Controlling in Section

3. Miscellaneous Property in Sec.

4. Lot No. \_\_\_\_\_, Recorded Plat \_\_\_\_\_  
5. Private Claims \_\_\_\_\_

STATE OF MICHIGAN  
COUNTY OF KENT  
RECEIVED FOR RECORD

95 JUN -7 AM 8:28

REG. OF DEEDS

*Lucy Bond*

**9172**

Register of Deeds Stamp & File Number

I, Kirk Breitels, in a field survey on Mar. 21, 1996 do hereby state that under requirements of P.A. 74, Michigan P.A. of 1970, the corner points mentioned in lines 1 and 2 above were in conformance with regulations and rules therefore as required in the current manual of survey instructions of the United States Department of the Interior, Bureau of Land Management or by a decree of a Court of Law and/or that the corner points mentioned in lines 3, 4 and 5 above were in conformance with the rules of the Michigan Board of Land Surveyors or by a Decree of a Court of Law, established, re-established, monumented, recovered, found as expressed below:

NOTE: Not more than 2 corners, all in the same town and range, may be recorded on this certificate.

1	A	B	C	D	E	F	G	H	I	J	K	L	M
2	6		5		4		3		2		1		
3													
4	7		8		9		10		11		12		
5													
6	10		17		16		15		14		13		
7													
8	19		20		21		22		23		24		
9													
10	30		29		28		27		26		25		
11													
12	31		32		33		34		35		36		
13													

A. Description of original monument and accessories and/or subsequent restoration:

M-2	1831	GLO	Mullett	Set Post	P.A. 345 1990 KENT COUNTY
		Kent Co. Wit.		Iron	PEER APPROVED <u>5/30/96</u>
	1971	LCRC #46	Chmabers	Iron	CHAIRMAN <i>Henry Huber</i>
	1972	LCRC #267	VanKooten	Iron	
	1981	LCRC #1603	Merdzinski	Set Kent County Monument	
	1991	LCRC #6059	Unema	Kent County Monument	

The position of this corner was previously approved by the Kent County Remonumentation Peer Group, monumented by John A. Merdzinski on 1/27/81 and was recorded per LCRC #1603

B. Description of corner evidence found and/or method applied in restoring or reestablishing corner:


M-2 Found standard Kent Co. Mon. (Harrison) per witnesses from above LCRC as set by John A. Merdzinski in place of the 3/4" Iron Pipe he found. Said Iron checks with Kent Co. Wit. and LCRC's #46 & #267

<u>LCRC #1603 (Nail/tag in trees)</u>	<u>LCRC #6059</u>
16" Chestnut South 11.73'	Nail/tag 28" Oak N80°E 5.84'
10" Oak S70°W 34.22'	Nail/tag 16" Chestnut S03°W 11.73'
24" Hickory West 38.09'	Nail/tag 12" Oak S72°W 33.88'
8" Cherry N15°W 34.95'	Nail/tag 12" Cherry N15°W 34.92'
12" Oak N40°W 29.27'	Nail/tag 14" Oak N39°E 29.28'

The selected location is accepted by me and is generally accepted by professional surveyors as the best available evidence of the position of the original corner.

C. Description of monument for corner and accessories established to perpetuate locating the position of the corner:

M-2 Standard Kent County Monument	
Nail & KC Remon. tag N. side 30" Oak	N80°E 5.84'
Nail & KC Remon. tag W. side 18" Chestnut	S03°W 11.76'
Nail & KC Remon. tag SE side 14" Oak	S72°W 33.94'
Nail & KC Remon. tag W. side 12" Cherry	N15°W 34.97'
Nail & KC Remon. tag NW side 16" Oak	N39°E 29.31'
Traces of old wire fence to N, E, W	

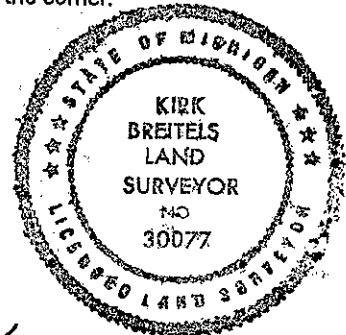

Signed by *Kirk Breitels*  
Surveyor's Michigan License No. 30077

Date 4/19/96