

SURVEY & REMONUMENTATION

FEB 14 1997
COMMISSION

KENT COUNTY REMONUMENTATION

LAND CORNER RECORDATION CERTIFICATE
Filing Requirement of Act 74, Mich. P.A. 1970

For corners in
KENT COUNTY
(County)

Located In: Corner Code #
T 6N R 10W M-4
T R
T R
T R
S T R
S T R
S T R
S T R

STATE OF MICHIGAN
COUNTY OF KENT
RECEIVED FOR RECORD
96 MAR 20 AM 8:48
REG. OF DEEDS
Lucy Bond

9003

Register of Deeds Stamp & File Number

4. Lot No. _____, Recorded Plat _____
5. Private Claims _____

I, Kirk Breitels, in a field survey on Feb. 12, 1996 do hereby state that under requirements of P.A. 74, Michigan P.A. of 1970, the corner points mentioned in lines 1 and 2 above were in conformance with regulations and rules therefore as required in the current manual of survey instructions of the United States Department of the Interior, Bureau of Land Management or by a decree of a Court of Law and/or that the corner points mentioned in lines 3, 4 and 5 above were in conformance with the rules of the Michigan Board of Land Surveyors or by a Decree of a Court of Law, established, re-established, monumented, recovered, found as expressed below:

NOTE: Not more than 2 corners, all in the same town and range, may be recorded on this certificate.

A	B	C	D	E	F	G	H	I	J	K	L	M
1												
2	6		5		4		3		2		1	
3												
4	7		8		9		10		11		12	
5												
6	10		17		16		15		14		13	
7												
8	19		20		21		22		23		24	
9												
10	30		29		28		27		26		25	
11												
12	31		32		33		34		35		36	
13												

P.A. 345 1990 KENT COUNTY
PEER APPROVED 3/7/96
CHAIRMAN *Harry Huber*

A. Description of original monument and accessories and/or subsequent restoration:

M-4	1831	GLO	Mullett	Set Post
	1938	Kent Co. Wit.		Concrete Monument
	1971	LCRC #45	Chambers	Concrete Monument
	1981	LCRC #1605		Set Kent County Monument
	1991	LCRC #6061	Unema	Kent County Monument

The position of this corner was previously approved by the Kent County Remonumentation Peer Group, monumented by John A. Merdzinski on 1/30/81 and was recorded per LCRC #1605

B. Description of corner evidence found and/or method applied in restoring or reestablishing corner:

M-4 Found standard Kent Co. Mon. (Harrison) per witnesses from above LCRC as set by John A. Merdzinski in place of the Concrete Monument he found. Said Concrete Monument checks with Kent Co. Wit. and LCRC #45.


<u>LCRC #1605 (Nail/tag in trees)</u>	<u>LCRC #6061 (Nail/tag in trees)</u>
14" Elm West 1.07'	6" Elm S10°E 19.05'
Tri. 6" Oak North 16.22'	Tri. 12" Oak N10°E 16.17'
8" Maple N50°E 26.22'	16" Elm West 1.19'
8" Elm S80°E 16.88'	12" Ash N51°E 26.10'
Tw. 6" Elm S10°E 19.05'	6" Elm S10°E 19.18'
	Tw. 6" Elm S45°E 4.30'
	Kent Co. Mon. A-4, 6-9 North 17.45'

The selected location is accepted by me and is generally accepted by professional surveyors as the best available evidence of the position of the original corner.

C. Description of monument for corner and accessories established to perpetuate locating the position of the corner:

M-4 Standard Kent County Monument

Nail & KC Remon. tag S. side 16" Elm	West	1.19'
Nail & KC Remon. tag E. side Tri. 12" Oak	N10°E	16.17'
New Nail & KC Remon. tag SE side 15" Ash	N51°E	26.10'
Nail NE side Twin 8" Elm	S45°E	4.30'
Nail W. side 8" Elm	S10°E	19.18'
Kent Co. Mon. (A-4, T6N, R9W)	North	17.45'
N-S fence is West 2'± and C/L creek is East 18'±		

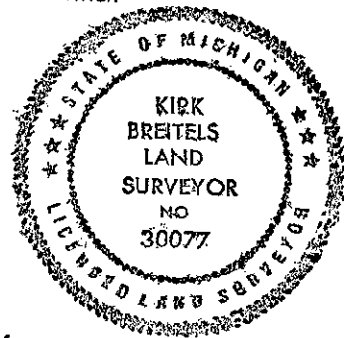

Signed by *Kirk Breitels*
Surveyor's Michigan License No. 30077

Date 3/1/96