

**SURVEY &
REMONUMENTATION**

KENT COUNTY REMONUMENTATION

FEB 14 1997

LAND CORNER RECORDATION CERTIFICATE
Filing Requirement of Act 74, Mich. P.A. 1970

For corners in
KENT COUNTY

COMMISSION

Located In:	Corner Code #
T <u>6N</u> R <u>10W</u>	<u>M-6</u>
T <u> </u> R <u> </u>	<u> </u>
T <u> </u> R <u> </u>	<u> </u>
T <u> </u> R <u> </u>	<u> </u>
S <u> </u> T <u> </u> R <u> </u>	<u> </u>
S <u> </u> T <u> </u> R <u> </u>	<u> </u>
S <u> </u> T <u> </u> R <u> </u>	<u> </u>
S <u> </u> T <u> </u> R <u> </u>	<u> </u>

STATE OF MICHIGAN
COUNTY OF KENT
RECEIVED FOR RECORD

96 MAR 20 AM 8:48

REG. OF DEEDS

9005

Register of Deeds Stamp & File Number

1. Public Land Survey

2. Property Controlling
in Section

3. Miscellaneous
Property in Sec.

4. Lot No. _____, Recorded Plat _____
5. Private Claims _____

I, Kirk Breitels, in a field survey on Feb. 8, 1996 do hereby state that under requirements of P.A. 74, Michigan P.A. of 1970, the corner points mentioned in lines 1 and 2 above were in conformance with regulations and rules therefore as required in the current manual of survey instructions of the United States Department of the Interior, Bureau of Land Management or by a decree of a Court of Law and for that the corner points mentioned in lines 3, 4 and 5 above were in conformance with the rules of the Michigan Board of Land Surveyors or by a Decree of a Court of Law; established, re-established, monumented, recovered, found as expressed below:

NOTE: Not more than 2 corners, all in the same town and range, may be recorded on this certificate.

	A	B	C	D	E	F	G	H	I	J	K	L	M
1													
2		6		5		4		3		2		1	
3													
4		7		8		9		10		11		12	
5													
6		18		17		16		15		14		13	
7													
8		19		20		21		22		23		24	
9													
10		30		29		28		27		26		25	
11													
12		31		32		33		34		35		36	
13													

A. Description of original monument and accessories and/or subsequent restoration:

M-6	1831	GLO	Mullett	Set Post
	1982	LCRC #2712	Merdzinski	PK Nail
	1982	LCRC #3105	Merdzinski	Set Kent County Monument
	1988	LCRC #4903	Chettleburgh	Kent County Monument
	1991	LCRC #6063	Unema	Kent County Monument

P.A. 345 1990 KENT COUNTY

PEER APPROVED 3/7/96
CHAIRMAN [Signature]

The position of this corner was previously approved by the Kent County Remonumentation Peer Group, monumented by John A. Merdzinski on 10/11/82 and was recorded per LCRC #3105

B. Description of corner evidence found and/or method applied in restoring or reestablishing corner:

M-6 Found standard Kent Co. Mon. (Harrison) per witnesses from above LCRC as set by John A. Merdzinski in place of the PK Nail he found. Said PK Nail checks with LCRC #2712 and information of others.

LCRC #6063, #4903, #3105


Nail & KC Remon. tag S. side P. Pole	N85°W	34.30'	KC Mon. A-6, 6-9
Nail & KC Remon. tag W. side 28" Walnut	N13°W	100.11'	North 25.73'
Nail & KC Remon. tag NW side P. Pole	N54°E	28.30'	
Nail & KC Remon. tag W. side 24" Hickory	S18°E	67.90'	
Nail & KC Remon. tag S. side 37" Oak	N64°W	64.56'	

The selected location is accepted by me and is generally accepted by professional surveyors as the best available evidence of the position of the original corner.

C. Description of monument for corner and accessories established to perpetuate locating the position of the corner:

M-6 Standard Kent County Monument

Nail & KC Remon. tag S. side P. Pole	N85°W	34.24'
Nail & KC Remon. tag W. side 30" Walnut	N13°W	100.07'
Nail & KC Remon. tag NW side P. Pole	N54°E	28.28'
Nail & KC Remon. tag W. side 27" Hickory	S18°E	68.00'
Nail & KC Remon. tag S. side 40" Oak	N64°W	64.56'
Nail & KC Remon. tag NW side 30" Pine	N25°E	89.11'
Nail & KC Remon. tag NW side 28" Pine	N35°E	63.39'
Kent Co. Mon. (A-6, T6N, R9W)	North	25.76'

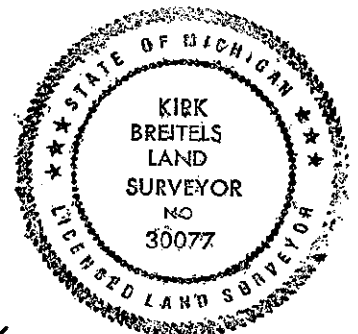

Signed by [Signature]
Surveyor's Michigan License No. 30077

Date 3/1/96