

SURVEY & REMONUMENTATION

FEB 14 1997

KENT COUNTY REMONUMENTATION

COMMISSION LAND CORNER RECORDATION CERTIFICATE
 Filing Requirement of Act 74, Mich. P.A. 1970

For corners in
KENT COUNTY

(County)

Located In:	Corner Code #
T 6N R 10W	M-10
T R	
T R	
T R	
T R	
S T R	
S T R	
S T R	
S T R	

1. Public Land Survey

2. Property Controlling in Section

3. Miscellaneous Property in Sec.

4. Lot No. _____, Recorded Plat _____

5. Private Claims _____

STATE OF MICHIGAN
 COUNTY OF KENT
 RECEIVED FOR RECORD

95 MAR 20 AM 8:48

REG. OF DEEDS

Lucy Hand

9009

Register of Deeds Stamp & File Number

I, Kirk Breitels, in a field survey on Feb. 1, 1996 do hereby state that under requirements of P.A. 74, Michigan P.A. of 1970, the corner points mentioned in lines 1 and 2 above were in conformance with regulations and rules therefore as required in the current manual of survey instructions of the United States Department of the Interior, Bureau of Land Management or by a decree of a Court of Law and /or that the corner points mentioned in lines 3, 4 and 5 above were in conformance with the rules of the Michigan Board of Land Surveyors or by a Decree of a Court of Law; established, re-established, monumented, recovered, found as expressed below:

NOTE: Not more than 2 corners, all in the same town and range, may be recorded on this certificate.

	A	B	C	D	E	F	G	H	I	J	K	L	M
1													
2	6		5		4		3		2		1		
3													
4	7		8		9		10		11		12		
5													
6	10		17		16		15		14		13		
7													
8	19		20		21		22		23		24		
9													
10	30		29		28		27		26		25		
11													
12	31		32		33		34		35		36		
13													

A. Description of original monument and accessories and/or subsequent restoration:

M-10	1831	GLO	Mullett	Set Post
	1959	Kent Co. Wit.		1/2" Iron
	1983	LCRC #3699	Jonker	Set Kent County Monument
	1991	LCRC #6067	Unema	Kent County Monument

P.A. 345 1990 KENT COUNTY

PEER APPROVED 3/2/96
 CHAIRMAN Harry Huber

The position of this corner was previously approved by the Kent County Remonumentation Peer Group, monumented by Robert J. Jonker on 4/20/83 and was recorded per LCRC #3699

B. Description of corner evidence found and/or method applied in restoring or reestablishing corner:


M-10 Found standard Kent Co. Mon. (Harrison) per witnesses from above LCRC as set by Robert J. Jonker in place of the 1/2" Iron Pipe he found. Said Iron Pipe checks with Kent Co. Wit.

LCRC #3699	LCRC #6067
C/L top R/W marker S20°E 114.3'	S. edge conc. pvmnt. North 63.63'
SE cor. steel fc. post N85°W 55.08'	C/L top of R/W marker S15°E 114.21'
S. edge steel fc. post N90°E 55.17'	Nail/tag 6" Hickory S14°W 121.35'
E-W fence is N. 3.2'	Nail/tag 7" Tw. Ash S87°E 52.35'
N. edge grav. turnaround is N. 14'±	SE cor. steel fc. post N85°W 55.14'

The selected location is accepted by me and is generally accepted by professional surveyors as the best available evidence of the position of the original corner.

C. Description of monument for corner and accessories established to perpetuate locating the position of the corner:

M-10 Standard Kent County Monument	
S. edge conc. pvmnt. (E. bd. I-96)	North 63.63'
C/L top of R/W marker	S15°E 114.19'
Nail & KC Remon. tag E. side 6" Hickory	S14°W 121.29'
Nail & KC Remon. tag N. side 7" Tw. Ash	S87°E 52.35'
SE cor. steel cor. fence post	N85°W 55.14'
E-W fence is N. 3.2'±	
N. edge gravel turnaround is N. 12'±	

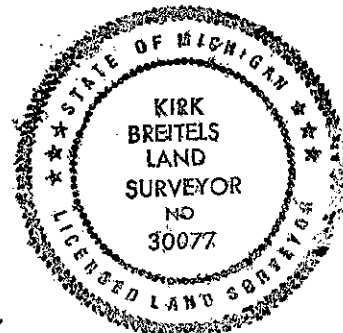

Signed by Kirk Breitels
 Surveyor's Michigan License No. 30077

Date 3/1/96