

**SURVEY & REMONUMENTATION**  
**FEB 14 1997**  
**COMMISSION**

**KENT COUNTY REMONUMENTATION**  
**LAND CORNER RECORDATION CERTIFICATE**  
**Filing Requirement of Act 74, Mich. P.A. 1970**

For corners in  
**KENT COUNTY**  
 (County)


Located In:	Corner Code #
T 6N R 10W	M-11
T 6N R 9W	A-11
T R	
T R	
T R	
S T R	
S T R	
S T R	
S T R	

- Public Land Survey
- Property Controlling in Section
- Miscellaneous Property in Sec.
- Lot No. \_\_\_\_\_, Recorded Plat \_\_\_\_\_
- Private Claims \_\_\_\_\_

STATE OF MICHIGAN  
 COUNTY OF KENT  
 RECEIVED FOR RECORD  
 96 JUN -7 AM 8:28  
 REG. OF DEEDS

**9173**

Register of Deeds Stamp & File Number

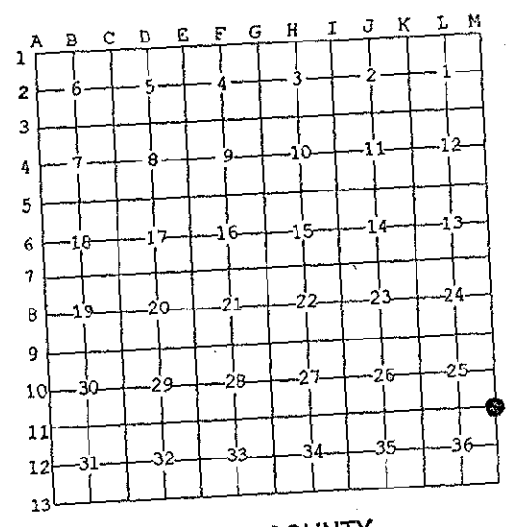

I, Kirk Breitels, in a field survey on Apr. 3, 19 96 do hereby state that under requirements of P.A. 74, Michigan P.A. of 1970, the corner points mentioned in lines 1 and 2 above were in conformance with regulations and rules therefore as required in the current manual of survey instructions of the United States Department of the Interior, Bureau of Land Management or by a decree of a Court of Law and/or that the corner points mentioned in lines 3, 4 and 5 above were in conformance with the rules of the Michigan Board of Land Surveyors or by a Decree of a Court of Law; established, re-established, monumented, recovered, found as expressed below:

NOTE: Not more than 2 corners, all in the same town and range, may be recorded on this certificate.

A. Description of original monument and accessories and/or subsequent restoration:

Date	Monument	Accessories	Restoration
M-11 1831	GLO	Mullett	Set Post
1959	Kent Co. Wit.		Conc. Mon.
1983	LCRC #3323	Stadt	Conc. Mon.
1983	LCRC #3608	Kolehouse	Set Kent County Monument
1991	LCRC #6052	Unema	Kent County Monument

P.A. 345 1990 KENT COUNTY  
 PEER APPROVED 5/30/96  
 CHAIRMAN Harry K. Kule

The position of this corner was previously approved by the Kent County Remonumentation Peer Group, monumented by Randy J. Kolehouse on 10/29/83 and was recorded per LCRC #3608

B. Description of corner evidence found and/or method applied in restoring or reestablishing corner:


M-11 Found standard Kent Co. Mon. (Harrison) per witnesses from above LCRC as set by Randy J. Kolehouse in place of the Conc. Mon. he found. Said Conc. Mon. checks with Kent Co. Wit. and LCRC #3323.

Monument	Direction	Distance	Monument	Direction	Distance
Nail/tag 16" Hickory	S40°W	32.45'	Nail/tag 18" Hickory	S40°W	32.65'
Nail/tag P. Pole	S25°E	58.20'	Nail/tag 6" Elm clump	N12°W	91.12'
Nail/tag P. Pole	N10°E	141.60'	Nail/tag P. Pole	S20°E	58.21'
C/L stop sign post	N20°W	42.65'	Nail/tag P. Pole	N11°E	141.55'

The selected location is accepted by me and is generally accepted by professional surveyors as the best available evidence of the position of the original corner.

C. Description of monument for corner and accessories established to perpetuate locating the position of the corner:

Monument	Direction	Distance
M-11 Standard Kent County Monument		
Nail & KC Remon. tag NW side	20" Hickory S40°W	32.65'
Nail & KC Remon. tag E. side	6" Elm clump N12°W	91.20'
Nail & KC Remon. tag W. side	P. Pole S20°E	58.21'
Nail & KC Remon. tag W. side	P. Pole N11°E	141.60'
C/L 52nd is	2.8' N.	
C/L gravel (Snow Ave.) is	4' E.	

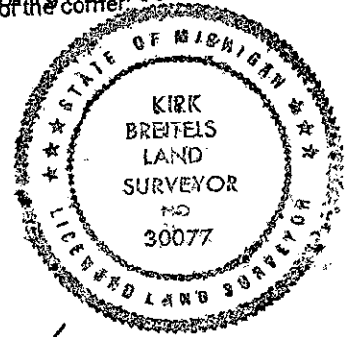

Signed by Kirk Breitels  
 Surveyor's Michigan License No. 30077

Date 4/19/96