

**SURVEY & REMONUMENTATION**

APR 27 1995

**COMMISSION**

KENT COUNTY REMONUMENTATION

**LAND CORNER RECORDATION CERTIFICATE**  
Filing Requirement of Act 74, Mich. P.A. 1970

STATE OF MICHIGAN  
COUNTY OF KENT  
RECEIVED FOR RECORD

94 DEC -5 AM 8:52

*W. R. Byl*  
REG. OF DEEDS

7595

Register of Deeds Stamp & File Number

For corners in  
KENT COUNTY  
(County)

Located In:

Corner Code #

1. Public Land Survey	T <u>6N</u> R <u>11W</u>	<u>A-2</u>
	T _____ R _____	_____
	T _____ R _____	_____
	T _____ R _____	_____
2. Property Controlling in Section	S _____ T _____ R _____	_____
	S _____ T _____ R _____	_____
3. Miscellaneous Property in Sec.	S _____ T _____ R _____	_____
	S _____ T _____ R _____	_____

4. Lot No. \_\_\_\_\_, Recorded Plat \_\_\_\_\_  
5. Private Claims \_\_\_\_\_

	A	B	C	D	E	F	G	H	I	J	K	L	M
2	6	5	4	3	2	1							
3													
4	7	8	9	10	11	12							
5													
6	18	17	16	15	14	13							
7													
8	19	20	21	22	23	24							
9													
10	30	29	28	27	26	25							
11													
12	31	32	33	34	35	36							
13													

I, William R. Byl, in a field survey on Oct. 10, 19 94, do hereby certify that under requirements of P.A. 74, Michigan P.A. of 1970, the corner points mentioned in lines 1 and 2 above were in conformance with regulations and rules therefore as required in the current manual of survey instructions of the United States Department of the Interior, Bureau of Land Management or by a decree of a Court of Law and/or that the corner points mentioned in lines 3, 4 and 5 above were in conformance with the rules of the Michigan Board of Land Surveyors or by a Decree of a Court of Law; established, re-established, monumented, re-monumented, recovered, found as expressed below:

**NOTE: Not more than 4 corners, all in the same town and range, may be recorded on this certificate.**

A. Description of original monument and accessories and/or subsequent restoration:

A-2 1831 GLO  
1906-1929 Williams & Works  
1931, 1956 City of Grand Rapids  
1984 LCRC #3904  
1988 LCRC #4727

Not Set  
City Iron  
City Iron  
Set Kent County Monument  
Kent County Monument

P.A. 345 1990 KENT COUNTY

PEER APPROVED 12/1/94  
CHAIRMAN *W. R. Byl*

The position of this corner was previously approved by the Kent County Remonumentation Peer Group, monumented by William R. Byl on 4/9/84 and was recorded per LCRC #3904

B. Description of corner evidence found and/or method applied in restoring or reestablishing corner:

A-2 Found standard Kent Co. Mon. (Harrison) per witnesses from above LCRC as set by William R. Byl. Said Kent Co. Mon. was set (City Iron gone) from 3 remaining 1906 City of Grand Rapids witnesses and checks with Williams & Works information and fits street centerlines.

LCRC #3904

LCRC #4727

SE cor. stone fnd. bldg.	N35°W	50.06'	SW cor. of brick bldg.	N55°E	53.82'
SW cor. brick bldg.	N55°E	53.82'	NW cor. of brick bldg.	S40°E	60.78'
NW cor. brick bldg.	S40°E	60.78'	"V" cut face Lt. Pole	S75°W	26.97'
"V" cut in face Lt. Pole	S75°W	26.97'	Top C/L Hydr.	N28°W	71.09'
Kent Co. Mon. (M-2 6-12)	N00°E	19.80'	KC Mon. (M-2 6-12)	N00°E	19.80'


On C/L Bit. Rd. N-S-E

The selected location is accepted by me and is generally accepted by professional surveyors as the best available evidence of the position of the corner.

C. Description of monument for corner and accessories established to perpetuate locating the position of the corner:

A-2 Standard Kent County Monument

SW cor. of brick bldg. N55°E 53.82'  
NW cor. of brick bldg. S40°E 60.75'  
"V" cut face Lt. Pole S75°W 26.94'  
Top C/L Hydr. N28°W 71.09'  
KC Mon. (E 1/4 Sec. 1, T6N, R12W) N00°E 19.80'  
On C/L Bit. Rd. N-S-E

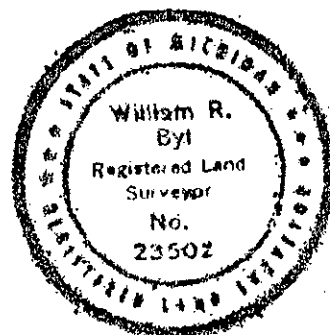

Signed by *W. R. Byl* Date 11/27/94  
Surveyor's Michigan License No. 23502