

**SURVEY & REMONUMENTATION**

APR 27 1995

KENT COUNTY REMONUMENTATION

STATE OF MICHIGAN  
COUNTY OF KENT  
RECEIVED FOR RECORD

94 DEC -5 AM 8:52

**LAND CORNER RECORDATION CERTIFICATE**  
Filing Requirement of Act 74, Mich. P.A. 1970

**COMMISSION**

For corners in  
KENT COUNTY

(County)

Located In:

Corner Code #

1. Public Land Survey	T 6N R 11W	A-3
	T _____ R _____	_____
	T _____ R _____	_____
	T _____ R _____	_____
2. Property Controlling in Section	S _____ T _____ R _____	_____
	S _____ T _____ R _____	_____
3. Miscellaneous Property in Sec.	S _____ T _____ R _____	_____
	S _____ T _____ R _____	_____

*Lexi Bond*  
REG. OF DEEDS

7596

Register of Deeds Stamp & File Number

4. Lot No. \_\_\_\_\_, Recorded Plat \_\_\_\_\_  
5. Private Claims \_\_\_\_\_

A	B	C	D	E	F	G	H	I	J	K	L	M
2	6	5	4	3	2	1						
3												
4	7	8	9	10	11	12						
5												
6	18	17	16	15	14	13						
7												
8	19	20	21	22	23	24						
9												
10	30	29	28	27	26	25						
11												
12	31	32	33	34	35	36						
13												

I, William R. Byl, in a field survey on Oct. 10, 19 94, do hereby certify that under requirements of P.A. 74, Michigan P.A. of 1970, the corner points mentioned in lines 1 and 2 above were in conformance with regulations and rules theretofore as required in the current manual of survey instructions of the United States Department of the Interior, Bureau of Land Management or by a decree of a Court of Law and/or that the corner points mentioned in lines 3, 4 and 5 above were in conformance with the rules of the Michigan Board of Land Surveyors or by a Decree of a Court of Law; established, re-established, monumented, re-monumented, recovered, found as expressed below:

**NOTE: Not more than 4 corners, all in the same town and range, may be recorded on this certificate.**

A. Description of original monument and accessories and/or subsequent restoration:

A-3	1831	GLO	Mullett	Set Post
	1905-1950	Williams & Works		"Corner 19.84' S. of NE 12-6-12"
	1931	City of Grand Rapids		"Corner 19.84' S. of NE 12-6-12"
	1984	LCRC #3905	Byl	Set Kent County Monument
	1988	LCRC #4728	Bueche	Kent County Monument

The position of this corner was previously approved by the Kent County Remonumentation Peer Group, monumented by William R. Byl on 9/14/84 and was recorded per LCRC #3905

B. Description of corner evidence found and/or method applied in restoring or reestablishing corner:

A-3 Found standard Kent Co. Mon. (Harrison) per witnesses from above LCRC as set by William R. Byl on Twp. line 19.84' S. of a City Iron (now Kent Co. Mon.) he found in a mon box at the NE cor. Sec. 12, T6N, R12W.

<u>LCRC #3905</u>	<u>LCRC #4728</u>
SE cor. marble bldg. N35°W 67.20'	SE cor. marble bldg. N35°W 67.20'
NE cor. fnd. bldg. S60°W 40.79'	NE cor. fnd. of bank bldg. S72°W 40.79'
"X" cut in conc. sign post base N40°E 68.33'	"X" Cut in conc. sign post base N40°E 68.33'
"X" cut in SW cor. bus stop shelter S45°E 67.63'	"X" Cut in SW cor. base of bus stop shelter S45°E 67.63'
KC Mon. (M-3 6-12) N00°E 19.84'	KC Mon. (NE cor. Sec. 12-6-12) N00°E 19.84'
	On C/L Bit. Rd. N-S

The selected location is accepted by me and is generally accepted by professional surveyors as the best available evidence of the position of the original corner.


C. Description of monument for corner and accessories established to perpetuate locating the position of the corner:

A-3 Standard Kent County Monument	
SE cor. marble bldg.	N35°W 67.20'
NE cor. fnd. of bank bldg.	S72°W 40.79'
"X" Cut in conc. sign post base	N40°E 68.33'
"X" Cut in SW cor. base of bus stop shelter	S45°E 67.63'
KC Mon. (NE cor. Sec. 12-6-12)	N00°E 19.84'
On C/L Bit. Rd. N-S	

P.A. 345 1990 KENT COUNTY

PEER APPROVED 12/1/94

CHAIRMAN Harry Kube

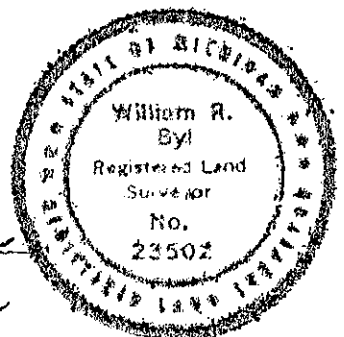

Signed by William R. Byl Surveyor's Michigan License No. 23502

Date 11/27/94