

# SURVEY & REMONUMENTATION

KENT COUNTY REMONUMENTATION

APR 27 1995

## LAND CORNER RECORDATION CERTIFICATE Filing Requirement of Act 74, Mich. P.A. 1970

STATE OF MICHIGAN  
COUNTY OF KENT  
RECEIVED FOR RECORD  
94 DEC -5 AM 8:52

### COMMISSION

For corners in  
KENT COUNTY  
(County)

Located In: Corner Code #

1. Public Land Survey	T 6N R 11W	A-6
	T R	
	T R	
	T R	
2. Property Controlling in Section	S T R	
	S T R	
3. Miscellaneous Property in Sec.	S T R	
	S T R	

*Luigi J. Bond*  
REG. OF DEEDS

7598

Register of Deeds Stamp & File Number

4. Lot No. \_\_\_\_\_, Recorded Plat \_\_\_\_\_  
5. Private Claims \_\_\_\_\_

A	B	C	D	E	F	G	H	I	J	K	L	M
2	6	5	4	3	2	1						
3												
4	7	8	9	10	11	12						
5												
6	18	17	16	15	14	13						
7												
8	19	20	21	22	23	24						
9												
10	30	29	28	27	26	25						
11												
12	31	32	33	34	35	36						
13												

I, William R. Byl, in a field survey on Oct. 10, 19 94, do hereby certify that under requirements of P.A. 74, Michigan P.A. of 1970, the corner points mentioned in lines 1 and 2 above were in conformance with regulations and rules theretofore as required in the current manual of survey instructions of the United States Department of the Interior, Bureau of Land Management or by a decree of a Court of Law and/or that the corner points mentioned in lines 3, 4 and 5 above were in conformance with the rules of the Michigan Board of Land Surveyors or by a Decree of a Court of Law; established, re-established, monumented, re-monumented, recovered, found as expressed below:

**NOTE: Not more than 4 corners, all in the same town and range, may be recorded on this certificate.**

**A. Description of original monument and accessories and/or subsequent restoration:**

A-6	1831	GLO	Not Set
	1904-1966	Williams & Works	Stake-Iron-"X" cut-Mon. Box
	1980	City of Wyoming	No desc. of corner-witnesses given
	1984	LCRC #3948	Byl Set 1/2" Rod with "KENT CO. REMON." cap
	1988	LCRC #4730	Bueche 1/2" Rod with "KENT CO. REMON." cap

The position of this corner was previously approved by the Kent County Remonumentation Peer Group, monumented by William R. Byl on 4/12/84 and was recorded per LCRC #3948

**B. Description of corner evidence found and/or method applied in restoring or reestablishing corner:**

A-6 Found 1/2" Rod with "KENT CO. REMON." cap per witnesses from above LCRC as set by William R. Byl in place of the 1" Iron Pipe he found in a mon. box. Said 1" Iron Pipe in mon. box. checks with survey information by others and previous measurement to M-6 T6N, R12W (Kent Co. Mon.). Witnesses prior to 1980 removed during road const. in 1980.  
LCRC #3948 LCRC #4730

C/L S. bolt traffic Lt. Pole base	N35°W	79.11'	same witnesses as LCRC #3948
C/L top of hydrant	S50°W	51.08'	
C/L top of hydrant	S35°E	55.13'	
C/L N. bolt traffic Lt. Pole base	S65°E	54.63'	
Kent Co. Mon. (M-6 6-12)	N00°E	27.76'	

The selected location is accepted by me and is generally accepted by professional surveyors as the best available evidence of the position of the corner.


**C. Description of monument for corner and accessories established to perpetuate locating the position of the corner:**

A-6	1/2" Rod with "KENT CO. REMON." cap in mon. box
C/L S. bolt traffic Lt. Pole base	N35°W 79.06'
C/L top of hydrant	S50°W 51.23'
C/L top of hydrant	S35°E 55.16'
C/L N. bolt traffic Lt. Pole base	S65°E 54.63'
Kent Co. Mon. (E 1/4 cor. Sec. 13, T6N, R12W)	N00°E 27.79'

P.A. 345 1990 KENT COUNTY

PEER APPROVED 12/1/99

CHAIRMAN Harry Thubert

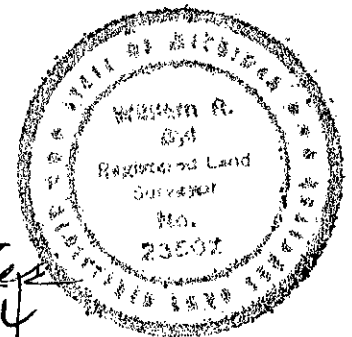

Signed by W. R. Byl Date 11/27/94  
Surveyor's Michigan License No. 23502