

SURVEY & REMONUMENTATION

KENT COUNTY REMONUMENTATION

APR 27 1995

LAND CORNER RECORDATION CERTIFICATE
Filing Requirement of Act 74, Mich. P.A. 1970

COMMISSION

For corners in
KENT COUNTY
(County)

	Located In:	Corner Code #
1. Public Land Survey	T 6N R 11W	A-12
	T _____ R _____	_____
	T _____ R _____	_____
	T _____ R _____	_____
2. Property Controlling in Section	S _____ T _____ R _____	_____
	S _____ T _____ R _____	_____
3. Miscellaneous Property in Sec.	S _____ T _____ R _____	_____
	S _____ T _____ R _____	_____

STATE OF MICHIGAN
COUNTY OF KENT
RECEIVED FOR RECORD
94 DEC -5 AM 8:53

W. R. Byl
REG. OF DEEDS

7604

Register of Deeds Stamp & File Number

4. Lot No. _____, Recorded Plat _____
5. Private Claims _____

I, William R. Byl, in a field survey on Oct. 10, 19 94, do hereby certify that under requirements of P.A. 74, Michigan P.A. of 1970, the corner points mentioned in lines 1 and 2 above were in conformance with regulations and rules therefore as required in the current manual of survey instructions of the United States Department of the Interior, Bureau of Land Management or by a decree of a Court of Law and/or that the corner points mentioned in lines 3, 4 and 5 above were in conformance with the rules of the Michigan Board of Land Surveyors or by a Decree of a Court of Law; established, re-established, monumented, re-monumented, recovered, found as expressed below:

	A	B	C	D	E	F	G	H	I	J	K	L	M
2	6	5	4	3	2	1							
3													
4	7	8	9	10	11	12							
5													
6	18	17	16	15	14	13							
7													
8	19	20	21	22	23	24							
9													
10	30	29	28	27	26	25							
11													
12	31	32	33	34	35	36							
13													

NOTE: Not more than 4 corners, all in the same town and range, may be recorded on this certificate.

A. Description of original monument and accessories and/or subsequent restoration:

A-12	1831 GLO	Not Set
	1926-76 Williams & Works	Iron in mon. box
	Kent Co. Wit.	Iron in mon. box
	1974 LCRC #670	VanKooten 3/4" Iron in mon. box
	1984 LCRC #3909	Byl Set Kent County Monument
	1988 LCRC #4736	Bueche Kent County Monument

The position of this corner was previously approved by the Kent County Remonumentation Peer Group, monumented by William R. Byl on 4/2/84 and was recorded per LCRC #3909

B. Description of corner evidence found and/or method applied in restoring or reestablishing corner:

A-12 Found standard Kent Co. Mon. (Harrison) per witnesses from above LCRC as set by William R. Byl in place of the 3/4" Iron Pipe he found in a mon. box. Said 3/4" Iron Pipe in a mon. box checks with Williams & Works, Kent Co. Wit. and LCRC #670

<u>LCRC #3909</u>	Nail & tag S. sd. 48" Sycamore	N80°W	90.01'	same witnesses as LCRC #3909
	Nail & tag S. sd. Tel. Pole	N65°E	38.06'	
	Nail & tag E. sd. Tel. Pole	S20°E	104.54'	
	Nail & tag S. sd. Power Pole	N60°W	32.70'	
	Nail & tag N. sd. Tel. Pole	S55°W	57.49'	
	Face of curb	N90°E	23.04'	
	Kent Co. Mon. (E 1/4, 36-6-12)	S00°E	11.00'	


P.A. 345 1990 KENT COUNTY
PEER APPROVED 12/1/94
CHAIRMAN *Harry Bueche*

The selected location is accepted by me and is generally accepted by professional surveyors as the best available evidence of the position of the corner.

C. Description of monument for corner and accessories established to perpetuate locating the position of the corner:

A-12 Standard Kent County Monument

New Nail & tag S. sd. 52" Sycamore	N80°W	90.05'
Nail & tag S. sd. Tel. Pole	N65°E	38.04'
Nail & tag E. sd. Tel. Pole	S20°E	104.60'
Nail & tag S. sd. Power Pole	N60°W	32.74'
Nail & tag N. sd. Tel. Pole	S55°W	57.49'
Face of curb	N90°E	23.08'
Kent Co. Mon. (E 1/4, 36-6-12)	S00°E	11.00'

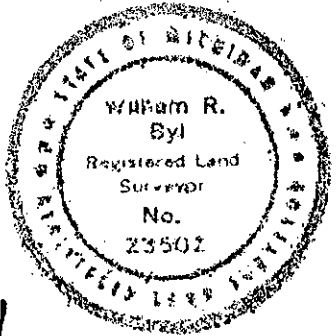

Signed by *W. R. Byl* Date 11/27/94
Surveyor's Michigan License No. 23502