

APR 27 1995

KENT COUNTY REMONUMENTATION

STATE OF MICHIGAN
COUNTY OF KENT
RECEIVED FOR RECORD

COMMISSION

LAND CORNER RECORDATION CERTIFICATE
Filing Requirement of Act 74, Mich. P.A. 1970

94 DEC -5 AM 8:53

For corners in
KENT COUNTY
(County)

Located In: Corner Code #

- | | | | | | |
|------------------------------------|---|-----------|---|------------|------------|
| 1. Public Land Survey | T | <u>6N</u> | R | <u>11W</u> | <u>B-5</u> |
| | T | | R | | |
| | T | | R | | |
| | T | | R | | |
| 2. Property Controlling in Section | S | | T | R | |
| | S | | T | R | |
| 3. Miscellaneous Property in Sec. | S | | T | R | |
| | S | | T | R | |

T. J. Bond
REG. OF DEEDS

7607

Register of Deeds Stamp & File Number

4. Lot No. _____, Recorded Plat _____
5. Private Claims _____

I, William R. Byl, in a field survey on Oct. 3, 19 94, do hereby certify that under requirements of P.A. 74, Michigan P.A. of 1970, the corner points mentioned in lines 1 and 2 above were in conformance with regulations and rules therefore as required in the current manual of survey instructions of the United States Department of the Interior, Bureau of Land Management or by a decree of a Court of Law and/or that the corner points mentioned in lines 3, 4 and 5 above were in conformance with the rules of the Michigan Board of Land Surveyors or by a Decree of a Court of Law; established, re-established, monumented, re-monumented, recovered, found as expressed below:

A	B	C	D	E	F	G	H	I	J	K	L	M
2	6	5	4	3	2	1						
3												
4	7	8	9	10	11	12						
5	•											
6	18	17	16	15	14	13						
7												
8	19	20	21	22	23	24						
9												
10	30	29	28	27	26	25						
11												
12	31	32	33	34	35	36						
13												

NOTE: Not more than 4 corners, all in the same town and range, may be recorded on this certificate.

A. Description of original monument and accessories and/or subsequent restoration:

- | | | | | |
|-----|------|---------------|---------|--------------------------|
| B-5 | 1831 | GLO | Mullett | Set Post |
| | | Kent Co. Wit. | | Iron-Mon. box |
| | 1968 | MDOT | | |
| | 1974 | LCRC #667 | Clapp | Iron in mon. box |
| | 1984 | LCRC #4096 | Rosema | Set Kent County Monument |
| | 1992 | LCRC #6489 | Bueche | Kent County Monument |

P.A. 345 1990 KENT COUNTY
PEER APPROVED 12/1/94
CHAIRMAN Harry Huber

The position of this corner was previously approved by the Kent County Remonumentation Peer Group, monumented by Maurice J. Rosema on 10/17/84 and was recorded per LCRC #4096

B. Description of corner evidence found and/or method applied in restoring or reestablishing corner:


B-5 Found standard Kent Co. Mon. (Harrison) in a mon. box per witnesses from above LCRC as set by Maurice J. Rosema in place of the 1/2" Re-rod he found in a mon box. Said 1/2" Re-rod in a mon. box checks with MDOT witnesses and LCRC #667

<u>LCRC #4096</u>		<u>LCRC #6489</u>	
C/L top hydrant	S50°W 88.10'	C/L top hydrant	S50°W 88.10'
C/L top hydrant	N30°W 59.28'	C/L top hydrant	N30°W 59.22'
PK & remon. tag curb joint	S50°E 55.15'	N & W back walks	N30°W 64.00'
PK & remon. tag curb joint	N20°E 65.23'	"X" cut SW cor. conc. base for signal	S40°W 68.03'
		SE cor. conc. for sign base	N40°E 78.13'
		"X" cut in conc. for signal	S40°E 62.69'
		On C/L Bit. Rd. N-S-E-W	

The selected location is accepted by me and is generally accepted by professional surveyors as the best available evidence of the position of the original corner.

C. Description of monument for corner and accessories established to perpetuate locating the position of the corner:

- | | |
|--|---------------|
| B-5 Standard Kent County Monument. | |
| C/L top hydrant | S50°W 88.10' |
| C/L top hydrant (moved?) | N45°W 58.67' |
| N & W back walks | N30°W 63.92' |
| "X" cut SW cor. conc. base for signal | S40°W 67.98' |
| SW cor. conc. (N'yly of 2) for sign base | N40°E 78.07' |
| Set Nail & KC Remon. tag S. side P. Pole | S65°E 106.69' |
| NW bldg. cor. (siding) | S35°E 134.13' |
| On C/L Bit. Rd. N-S-E-W | |

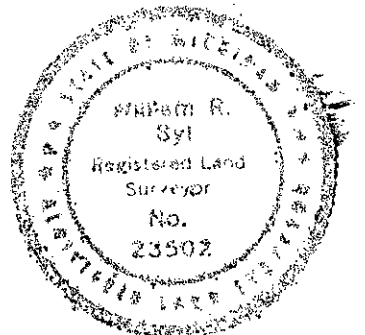

Signed by W. R. Byl Date 11/27/94

Surveyor's Michigan License No. 23502