

SURVEY & REMONUMENTATION

KENT COUNTY REMONUMENTATION

APR 27 1995

LAND CORNER RECORDATION CERTIFICATE
Filing Requirement of Act 74, Mich. P.A. 1970

STATE OF MICHIGAN
COUNTY OF KENT
RECEIVED FOR RECORD

94 DEC -5 AM 8:53

For corners in **COMMISSION**
KENT COUNTY
(County)

Located In:	Corner Code #
T <u>6N</u> R <u>11W</u>	<u>B-7</u>
T _____ R _____	_____
T _____ R _____	_____
T _____ R _____	_____
T _____ R _____	_____
S _____ T _____ R _____	_____
S _____ T _____ R _____	_____
S _____ T _____ R _____	_____
S _____ T _____ R _____	_____

Lee J. Bond
REG. OF DEEDS

7608

Register of Deeds Stamp & File Number

- 4. Lot No. _____, Recorded Plat _____
- 5. Private Claims _____

I, William R. Byl, in a field survey on Sept. 14, 19 94, do hereby certify that under requirements of P.A. 74, Michigan P.A. of 1970, the corner points mentioned in lines 1 and 2 above were in conformance with regulations and rules therefore as required in the current manual of survey instructions of the United States Department of the Interior, Bureau of Land Management or by a decree of a Court of Law and/or that the corner points mentioned in lines 3, 4 and 5 above were in conformance with the rules of the Michigan Board of Land Surveyors or by a Decree of a Court of Law; established, re-established, monumented, re-monumented, recovered, found as expressed below:

	A	B	C	D	E	F	G	H	I	J	K	L	M
2	6	5	4	3	2	1							
3													
4	7	8	9	10	11	12							
5													
6	18	17	16	15	14	13							
7	●												
8	19	20	21	22	23	24							
9													
10	30	29	28	27	26	25							
11													
12	31	32	33	34	35	36							
13													

NOTE: Not more than 4 corners, all in the same town and range, may be recorded on this certificate.

A. Description of original monument and accessories and/or subsequent restoration: P.A. 345 1990 KENT COUNTY
B-7 1831 GLO Mullett Set Post PEER APPROVED 12/1/94
1900-66 Williams & Works Conc. Mon. CHAIRMAN *Harry Huber*
1941 Kent Co. Wit. No. desc. of cor.-witnesses given
1984 LCRC #3911 Byl Set Kent County Monument
1992 LCRC #6490 Bueche Kent County Monument


The position of this corner was previously approved by the Kent County Remonumentation Peer Group, monumented by William R. Byl on 4/12/84 and was recorded per LCRC #3911

B. Description of corner evidence found and/or method applied in restoring or reestablishing corner:
B-7 Found standard Kent Co. Mon. (Harrison) per witnesses from above LCRC as set by William R. Byl in place of the Conc. Monument he found. Said Conc. Monument checks with lot irons in adjoining plats (all witnesses removed during road const. prior to 1984).
LCRC #3911 LCRC #6490

Nail & tag N. sd. 6" Maple	S90°W	3.79'	same witnesses as LCRC #3911
Back of curb	S00°W	11.58'	
Back of curb	N00°E	11.49'	
SE cor. brick bldg. #405	N05°E	89.38'	
SW cor. brick bldg. #405	N35°W	111.75'	
NE cor. brick bldg. #400	S10°E	121.48'	
NW cor. brick bldg. #400	S30°W	132.76'	

The selected location is accepted by me and is generally accepted by professional surveyors as the best available evidence of the position of the original corner.

C. Description of monument for corner and accessories established to perpetuate locating the position of the corner:
B-7 Standard Kent County Monument
Nail & KC Remon. tag N. sd. 10" Maple S90°W 3.84'
Back of curb S00°W 11.58'
Back of curb N00°E 11.49'
SE cor. brick bldg. #405 N05°E 89.36'
SW cor. brick bldg. #405 N35°W 111.80'
NE cor. brick bldg. #400 S10°E 121.53'
NW cor. brick bldg. #400 S30°W 132.73'

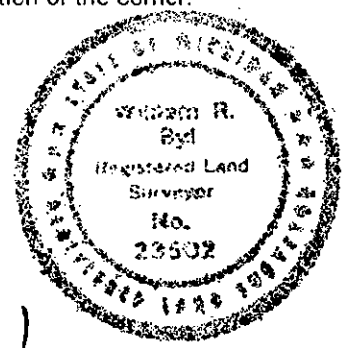

Signed by *W. R. Byl* Date 11/27/94
Surveyor's Michigan License No. 23502