

SURVEY & REMONUMENTATION

APR 27 1995

KENT COUNTY REMONUMENTATION

STATE OF MICHIGAN
COUNTY OF KENT
RECEIVED FOR RECORD

COMMISSION

LAND CORNER RECORDATION CERTIFICATE
Filing Requirement of Act 74, Mich. P.A. 1970

94 DEC -5 AM 8:53

For corners in
KENT COUNTY

(County)	Located In:	Corner Code -#
1. Public Land Survey	T <u>6N</u> R <u>11W</u>	<u>B-9</u>
	T _____ R _____	_____
	T _____ R _____	_____
	T _____ R _____	_____
2. Property Controlling in Section	S _____ T _____ R _____	_____
	S _____ T _____ R _____	_____
3. Miscellaneous Property in Sec.	S _____ T _____ R _____	_____
	S _____ T _____ R _____	_____

W. J. Bond
REG. OF DEEDS

7609

Register of Deeds Stamp & File Number

4. Lot No. _____, Recorded Plat _____
5. Private Claims _____

	A	B	C	D	E	F	G	H	I	J	K	L	M
2	6	5	4	3	2	1							
3													
4	7	8	9	10	11	12							
5													
6	18	17	16	15	14	13							
7													
8	19	20	21	22	23	24							
9													
10	30	29	28	27	26	25							
11													
12	31	32	33	34	35	36							
13													

I, William R. Byl, in a field survey on Sept. 28, 1994, do hereby certify that under requirements of P.A. 74, Michigan P.A. of 1970, the corner points mentioned in lines 1 and 2 above were in conformance with regulations and rules therefore as required in the current manual of survey instructions of the United States Department of the Interior, Bureau of Land Management or by a decree of a Court of Law and/or that the corner points mentioned in lines 3, 4 and 5 above were in conformance with the rules of the Michigan Board of Land Surveyors or by a Decree of a Court of Law; established, re-established, monumented, re-monumented, recovered, found as expressed below:

NOTE: Not more than 4 corners, all in the same town and range, may be recorded on this certificate.

A. Description of original monument and accessories and/or subsequent restoration:

B-9	1831	GLO	Mullett	Set Post
	1962	Kent Co. Wit.		Iron
	1979	LCRC #1265	Bonnema	1" Iron
	1981	LCRC #2479	Hackbardt	Set. Kent County Monument
	1992	LCRC #6491	Bueche	Kent County Monument

P.A. 345 1990 KENT COUNTY

PEER APPROVED 12/11/94
CHAIRMAN *Harry Huber*

The position of this corner was previously approved by the Kent County Remonumentation Peer Group, monumented by Glen S. Hackbardt on 9/23/81 and was recorded per LCRC #2479

B. Description of corner evidence found and/or method applied in restoring or reestablishing corner:


B-9 Found standard Kent Co. Mon. (Harrison) per witnesses from above LCRC as set by Glen S. Hackbardt in place of the 1" Iron he found. Said 1" Iron checks with LCRC #1265
LCRC #2479 LCRC #6491

C/L Hydrant	N40°W	47.23'	same witnesses as LCRC #2479
KC Nail & tag N. sd. CP	N60°W	62.93'	plus
NE cor. Porch fnd.	S50°W	78.70'	
NW cor. House fnd.	N40°E	97.10'	SE corner House #364 S20°W 116.73'
SW cor. House fnd.	S45°E	104.10'	On C/L Bit. Rd. E-W-N

The selected location is accepted by me and is generally accepted by professional surveyors as the best available evidence of the position of the original corner.

C. Description of monument for corner and accessories established to perpetuate locating the position of the corner:

B-9 Standard Kent County Monument			
C/L top Hydrant	N40°W	47.23'	
Nail & KC Remon. tag N. side P. Pole	N60°W	62.93'	
NE cor. Porch fnd. #364	S50°W	78.70'	
NW cor. House fnd.	N40°E	97.10'	
SE corner House #364	S20°W	116.73'	
SW cor. House fnd. #4406	S45°E	104.16'	
On C/L Bit. Rd. E-W-S			

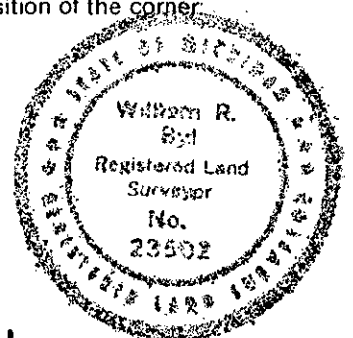

Signed by *W. R. Byl* Date 112794
Surveyor's Michigan License No. 23502