

SURVEY & REMONUMENTATION

KENT COUNTY REMONUMENTATION

APR 27 1995

LAND CORNER RECORDATION CERTIFICATE
Filing Requirement of Act 74, Mich. P.A. 1970

STATE OF MICHIGAN
 COUNTY OF KENT
 RECEIVED FOR RECORD

94 DEC -5 AM 8:54

W. R. Byl
 REG. OF DEEDS

For corners in **COMMISSION**
KENT COUNTY

(County)

Located In: Corner Code =#

- | | | |
|------------------------------------|--------------------------|-------------|
| 1. Public Land Survey | T <u>6N</u> R <u>11W</u> | <u>B-11</u> |
| | T _____ R _____ | _____ |
| | T _____ R _____ | _____ |
| | T _____ R _____ | _____ |
| 2. Property Controlling in Section | S _____ T _____ R _____ | _____ |
| | S _____ T _____ R _____ | _____ |
| 3. Miscellaneous Property in Sec. | S _____ T _____ R _____ | _____ |
| | S _____ T _____ R _____ | _____ |

7610
 Register of Deeds Stamp & File Number

4. Lot No. _____, Recorded Plat _____
 5. Private Claims _____

A	B	C	D	E	F	G	H	I	J	K	L	M
2	6	5	4	3	2	1						
3												
4	7	8	9	10	11	12						
5												
6	18	17	16	15	14	13						
7												
8	19	20	21	22	23	24						
9												
10	30	29	28	27	26	25						
11	●											
12	31	32	33	34	35	36						
13												

I, William R. Byl, in a field survey on July 7, 19 94, do hereby certify that under requirements of P.A. 74, Michigan P.A. of 1970, the corner points mentioned in lines 1 and 2 above were in conformance with regulations and rules therefore as required in the current manual of survey instructions of the United States Department of the Interior, Bureau of Land Management or by a decree of a Court of Law and/or that the corner points mentioned in lines 3, 4 and 5 above were in conformance with the rules of the Michigan Board of Land Surveyors or by a Decree of a Court of Law; established, re-established, monumented, re-monumented, recovered, found as expressed below:

NOTE: Not more than 4 corners, all in the same town and range, may be recorded on this certificate.

A. Description of original monument and accessories and/or subsequent restoration:

B-11	1831	GLO	Mullett	Set Post	P.A. 345 1990 KENT COUNTY
	1972	LCRC #132	Chambers	3/4" Iron	PEER APPROVED <u>12/1/94</u>
	1982	LCRC #2998	Byl	Set Kent County Monument	CHAIRMAN <i>Henry Thubert</i>
	1987	LCRC #4511	Milliron	Reset Kent Co. Mon. after const.	
	1992	LCRC #6492	Bueche	Kent County Monument	

The position of this corner was previously approved by the Kent County Remonumentation Peer Group, monumented by William R. Byl on 5/20/82 and was recorded per LCRC #2998

B. Description of corner evidence found and/or method applied in restoring or reestablishing corner:

B-11 Found standard Kent Co. Mon. (Harrison) per witnesses from above LCRC as set by Rex Milliron at the same location as set by William R. Byl in 1982 in place of the PK Nail over a 3/4" x 12" Iron Pipe he found. Said Iron Pipe checks with LCRC #132.


<u>LCRC #2998</u>	<u>LCRC #6492</u>
NE cor. hse. fnd. S30°W 93.15'	Nail & KC Remon. tag W. side PP N 20.88'
NW cor. hse. fnd. S55°W 110.64'	Top C/L Hydrant S30°W 53.74'
NE cor. hse. fnd. S50°E 115.59'	SE cor. bottom step to hse. #405 N55°E 96.58'
Nail & tag P. Pole N75°W 119.00'	Nail & KC Remon. tag SW side PP S50°E 45.84'
	NE cor. house fnd. S30°W 93.15'

The selected location is accepted by me and is generally accepted by professional surveyors as the best available evidence of the position of the original corner.

C. Description of monument for corner and accessories established to perpetuate locating the position of the corner:

B-11 Standard Kent County Monument

Nail & KC Remon. tag W. side P. Pole	N00°E	20.88'
Top C/L Hydrant	S30°W	53.72'
SE cor. bottom step to hse. #405	N55°E	96.64'
Nail & KC Remon. tag SW side P. Pole	S50°E	45.84'
NE cor. house fnd.	S30°W	93.15'

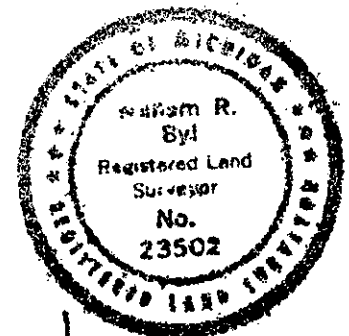

Signed by *W. R. Byl*
 Surveyor's Michigan License No. 23502

Date 11/27/94