

# SURVEY & REMONUMENTATION

APR 27 1995

KENT COUNTY REMONUMENTATION

COMMISSION

LAND CORNER RECORDATION CERTIFICATE  
Filing Requirement of Act 74, Mich. P.A. 1970

STATE OF MICHIGAN  
COUNTY OF KENT  
RECEIVED FOR RECORD

94 DEC -5 AM 8:54

*W. R. Byl*  
REG. OF DEEDS

For corners in  
KENT COUNTY

(County)	Located In:	Corner Code #
1. Public Land Survey	T <u>6N</u> R <u>11W</u>	<u>C-5</u>
	T _____ R _____	_____
	T _____ R _____	_____
	T _____ R _____	_____
2. Property Controlling in Section	S _____ T _____ R _____	_____
	S _____ T _____ R _____	_____
3. Miscellaneous Property in Sec.	S _____ T _____ R _____	_____
	S _____ T _____ R _____	_____

7616

Register of Deeds Stamp & File Number

4. Lot No. \_\_\_\_\_, Recorded Plat \_\_\_\_\_  
5. Private Claims \_\_\_\_\_

I, William R. Byl, in a field survey on Sept. 14, 19 94, do hereby certify that under requirements of P.A. 74, Michigan P.A. of 1970, the corner points mentioned in lines 1 and 2 above were in conformance with regulations and rules therefore as required in the current manual of survey instructions of the United States Department of the Interior, Bureau of Land Management or by a decree of a Court of Law and/or that the corner points mentioned in lines 3, 4 and 5 above were in conformance with the rules of the Michigan Board of Land Surveyors or by a Decree of a Court of Law; established, re-established, monumented, re-monumented, recovered, found as expressed below:

	A	B	C	D	E	F	G	H	I	J	K	L	M
2	6	5	4	3	2	1							
3													
4	7	8	9	10	11	12							
5													
6	18	17	16	15	14	13							
7													
8	19	20	21	22	23	24							
9													
10	30	29	28	27	26	25							
11													
12	31	32	33	34	35	36							
13													

**NOTE: Not more than 4 corners, all in the same town and range, may be recorded on this certificate.**

A. Description of original monument and accessories and/or subsequent restoration:

C-5	1831	GLO	Mullett	Set Post
	1968	MDOT		Witnesses given
	1974	LCRC #667	Clapp	Iron in Mon. Box
	1984	LCRC #4095	Rosema	Set Kent County Monument
	1992	LCRC #6497	Bueche	Kent County Monument

P.A. 345 1990 KENT COUNTY

PEER APPROVED 12/1/94

CHAIRMAN *Harry Bueche*

The position of this corner was previously approved by the Kent County Remonumentation Peer Group, monumented by Maurice J. Rosema on 10/18/84 and was recorded per LCRC #4095

B. Description of corner evidence found and/or method applied in restoring or reestablishing corner:


C-5 Found standard Kent Co. Mon. (Harrison) per witnesses from above LCRC as set by Maurice J. Rosema in place of the 1/2" Iron in he found in a mon. box. Said 1/2" Iron in mon. box checks with MDOT & LCRC #667

LCRC #4095	LCRC #6497
C/L top of hydrant S50°E 71.63'	C/L top of hydrant S50°E 73.78'
C/L top of hydrant N40°W 57.05'	Nail & KC Remon. tag PP S35°W 81.10'
Nail & tag P. Pole S35°W 81.17'	SE cor. conc. base for sign N45°E 72.33'
SE cor. casting CB N70°E 63.58'	C/L 1" NE bolt, signal control S30°W 82.05'
	"X" cut N. sd. conc. for Lt. base S35°E 88.84'
	"X" cut NE bolt for sign N30°W 63.40'

The selected location is accepted by me and is generally accepted by professional surveyors as the best available evidence of the position of the original corner.

C. Description of monument for corner and accessories established to perpetuate locating the position of the corner:

C-5 Standard Kent County Monument in mon. box	
C/L top of hydrant	S50°E 73.83'
Nail & KC Remon. tag W. side P. Pole	S35°W 81.10'
SE cor. conc. base for sign	N45°E 72.36'
"X" cut N. sd. conc. for light base	S35°E 88.84'
"X" cut NE bolt for sign	N30°W 63.32'

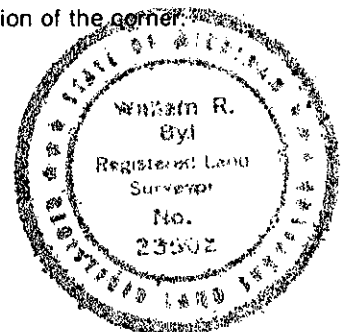

*W. R. Byl*

Signed by \_\_\_\_\_

Date 11/27/94

Surveyor's Michigan License No. 23502