

SURVEY & REMONUMENTATION

APR 27 1995

KENT COUNTY REMONUMENTATION

COMMISSION LAND CORNER RECORDATION CERTIFICATE Filing Requirement of Act 74, Mich. P.A. 1970

STATE OF MICHIGAN
COUNTY OF KENT
RECEIVED FOR RECORD
94 DEC -5 AM 8:54

For corners in
KENT COUNTY
(County)

Located In: Corner Code #

- | | | | |
|------------------------------------|--------------------------|------------|-------|
| 1. Public Land Survey | T <u>6N</u> R <u>11W</u> | <u>C-6</u> | |
| | T _____ R _____ | _____ | _____ |
| | T _____ R _____ | _____ | _____ |
| | T _____ R _____ | _____ | _____ |
| 2. Property Controlling in Section | S _____ T _____ R _____ | _____ | _____ |
| | S _____ T _____ R _____ | _____ | _____ |
| 3. Miscellaneous Property in Sec. | S _____ T _____ R _____ | _____ | _____ |
| | S _____ T _____ R _____ | _____ | _____ |

W. R. Byl
REG. OF DEEDS

7617

Register of Deeds Stamp & File Number

4. Lot No. _____, Recorded Plat _____
5. Private Claims _____

	A	B	C	D	E	F	G	H	I	J	K	L	M
2	6	5	4	3	2	1							
3													
4	7	8	9	10	11	12							
5													
6	18	17	16	15	14	13							
7													
8	19	20	21	22	23	24							
9													
10	30	29	28	27	26	25							
11													
12	31	32	33	34	35	36							
13													

I, William R. Byl, in a field survey on Oct. 6, 19 94, do hereby certify that under requirements of P.A. 74, Michigan P.A. of 1970, the corner points mentioned in lines 1 and 2 above were in conformance with regulations and rules therefore as required in the current manual of survey instructions of the United States Department of the Interior, Bureau of Land Management or by a decree of a Court of Law and/or that the corner points mentioned in lines 3, 4 and 5 above were in conformance with the rules of the Michigan Board of Land Surveyors or by a Decree of a Court of Law; established, re-established, monumented, re-monumented, recovered, found as expressed below:

NOTE: Not more than 4 corners, all in the same town and range, may be recorded on this certificate.

A. Description of original monument and accessories and/or subsequent restoration:

P.A. 345 1990 KENT COUNTY
PEER APPROVED 12/1/94
CHAIRMAN *Harry Huber*

- | | | | | |
|-----|------|---------------|-----------|--------------------------|
| C-6 | 1831 | GLO | Mullett | Set Post |
| | 1932 | Kent Co. Wit. | | Mon. Box |
| | 1974 | LCRC #723 | Nederveld | 1 1/4" Iron in mon. box |
| | 1981 | LCRC #2476 | Hackbardt | Set Kent County Monument |
| | 1990 | LCRC #5490 | Murphy | Kent County Monument |
| | 1992 | LCRC #6498 | Bueche | Kent County Monument |

The position of this corner was previously approved by the Kent County Remonumentation Peer Group, monumented by Glen S. Hackbardt on 9/10/81 and was recorded per LCRC #2476

B. Description of corner evidence found and/or method applied in restoring or reestablishing corner:


C-6 Found standard Kent Co. Mon. (Harrison) per witnesses from above LCRC as set by Glen S. Hackbardt in place of the 1" Iron he found in a mon. box. Said 1" Iron in a mon. box checks with LCRC #723.

<u>LCRC #2476</u>	<u>LCRC #6498</u>	
C/L hydrant	S70°W 60.20'	SW cor. bldg. (brick) #3130 N40°E 113.85'
NE cor. CB header	S50°E 44.73'	NE cor. bldg. (block) S65°W 126.42'
C/L manhole	N80°E 17.55'	NW cor. bldg. (brick) #3206 S85°E 123.21'
C/L manhole	N30°E 27.15'	SW cor. bldg. (brick) #3206 S55°E 146.14'
		SE cor. bldg. (at ground) N50°W 137.04'
		On C/L Bit. Rd. N-S-W

The selected location is accepted by me and is generally accepted by professional surveyors as the best available evidence of the position of the original corner.

C. Description of monument for corner and accessories established to perpetuate locating the position of the corner:

- C-6 Standard Kent County Monument in mon. box
- | | | |
|-----------------------------|---------------|--------------------------|
| SW cor. bldg. (brick) #3130 | N40°E 113.85' | |
| NE cor. bldg. (block) | S65°W 126.42' | |
| NW cor. bldg. (brick) #3206 | S85°E 123.15' | |
| SW cor. bldg. (brick) #3206 | S55°E 146.21' | |
| SE cor. bldg. (at ground) | N50°W 135.10' | (remodeled ? since 1992) |
| Re-rod with cap (MVK) | S90°E 50.10' | |
| On C/L Bit. Rd. N-S-W | | |

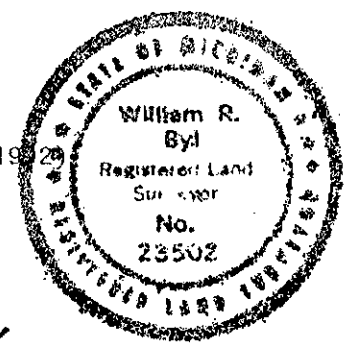

Signed by *W. R. Byl* Date 11/27/94
Surveyor's Michigan License No. 23502