

SURVEY & REMONUMENTATION

APR 27 1995

KENT COUNTY REMONUMENTATION

STATE OF MICHIGAN
COUNTY OF KENT
RECEIVED FOR RECORD

COMMISSION

LAND CORNER RECORDATION CERTIFICATE
Filing Requirement of Act 74, Mich. P.A. 1970

94 DEC -5 AM 8:55

For corners in
KENT COUNTY

(County)	Located In:	Corner Code #
1. Public Land Survey	T <u>6N</u> R <u>11W</u>	<u>C-7</u>
	T _____ R _____	_____
	T _____ R _____	_____
	T _____ R _____	_____
2. Property Controlling in Section	S _____ T _____ R _____	_____
	S _____ T _____ R _____	_____
3. Miscellaneous Property in Sec.	S _____ T _____ R _____	_____
	S _____ T _____ R _____	_____


Lee J. Bond
REG. OF DEEDS

7618

Register of Deeds Stamp & File Number

4. Lot No. _____, Recorded Plat _____
5. Private Claims _____

I, William R. Byl, in a field survey on Sept. 14, 19 94, do hereby certify that under requirements of P.A. 74, Michigan P.A. of 1970, the corner points mentioned in lines 1 and 2 above were in conformance with regulations and rules therefore as required in the current manual of survey instructions of the United States Department of the Interior, Bureau of Land Management or by a decree of a Court of Law and/or that the corner points mentioned in lines 3, 4 and 5 above were in conformance with the rules of the Michigan Board of Land Surveyors or by a Decree of a Court of Law; established, re-established, monumented, re-monumented, recovered, found as expressed below:

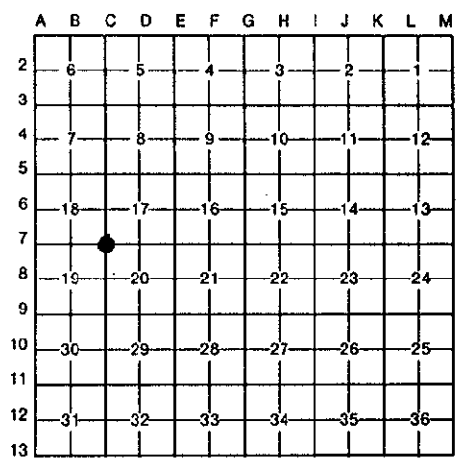

NOTE: Not more than 4 corners, all in the same town and range, may be recorded on this certificate.

A. Description of original monument and accessories and/or subsequent restoration:

C-7	1831	GLO	Mullett	Set Post
	1959	Kent Co. Wit.		Iron-Mon. Box
	1971	LCRC #49	Chambers	Iron in mon. box
	1981	LCRC #2475	Hackbardt	Set Kent County Monument
	1990	LCRC #5490	Murphy	Kent County Monument
	1992	LCRC #6499	Bueche	Kent County Monument

P.A. 345 1990 KENT COUNTY
PEER APPROVED 12/1/94
CHAIRMAN *Harry Huber*

The position of this corner was previously approved by the Kent County Remonumentation Peer Group, monumented by Glen S. Hackbardt on 9/10/81 and was recorded per LCRC #2475

B. Description of corner evidence found and/or method applied in restoring or reestablishing corner:


C-7 Found standard Kent Co. Mon. (Harrison) per witnesses from above LCRC as set by Glen S. Hackbardt in place of the 1 1/4" x 18" Iron he found in a mon. box. Said Iron in mon. box checks with Kent Co. Wit. and LCRC #49

LCRC #2475		LCRC #6499	
C/L hydrant	N55°W 83.20'	C/L hydrant	N55°W 83.20'
C/L hydrant	N88°W 35.60'	C/L hydrant	S60°W 81.99'
C/L hydrant	S50°W 83.05'	NE cor. CB header	S50°E 70.95'
NE cor. CB header	S50°E 72.01'	Nail & KC Remon. tag curb joint	N10°W 66.24'
		Nail & KC Remon. tag SE sd. PP	N60°E 82.43'
		Nail & bottle cap P. Pole	S60°E 85.85'
		Conc. nail KC Remon. tag curb joint	S10°W 62.18'

The selected location is accepted by me and is generally accepted by professional surveyors as the best available evidence of the position of the original corner.

C. Description of monument for corner and accessories established to perpetuate locating the position of the corner:

C-7 Standard Kent County Monument	
C/L top hydrant	N55°W 83.14'
C/L top hydrant	S60°W 81.99'
NE cor. CB header	S50°E 70.95'
Nail & KC Remon. tag in curb joint	N10°W 66.28'
Nail & KC Remon. tag SE side P. Pole	N60°E 82.47'
Nail & bottle cap NE side P. Pole	S60°E 85.82'
Conc. nail KC Remon. tag in curb joint	S10°W 62.18'
On C/L Bit. Rd. E-W-N; C/L Bit. Rd. S., East 14'	

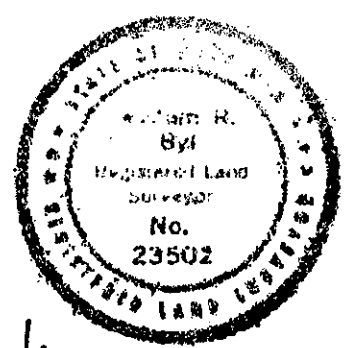

Signed by *W. R. Byl* Date 112794
Surveyor's Michigan License No. 23502