

# SURVEY & REMONUMENTATION

## KENT COUNTY REMONUMENTATION

APR 27 1995

### LAND CORNER RECORDATION CERTIFICATE Filing Requirement of Act 74, Mich. P.A. 1970

STATE OF MICHIGAN  
COUNTY OF KENT  
RECEIVED FOR RECORD

94 DEC -5 AM 8:55

#### COMMISSION

For corners in  
KENT COUNTY  
(County)

Located In: Corner Code #

- |                                    |                          |            |
|------------------------------------|--------------------------|------------|
| 1. Public Land Survey              | T <u>6N</u> R <u>11W</u> | <u>C-8</u> |
|                                    | T _____ R _____          | _____      |
|                                    | T _____ R _____          | _____      |
|                                    | T _____ R _____          | _____      |
| 2. Property Controlling in Section | S _____ T _____ R _____  | _____      |
|                                    | S _____ T _____ R _____  | _____      |
| 3. Miscellaneous Property in Sec.  | S _____ T _____ R _____  | _____      |
|                                    | S _____ T _____ R _____  | _____      |

*W. R. Byl*  
REG. OF DEEDS

7619

Register of Deeds Stamp & File Number

4. Lot No. \_\_\_\_\_, Recorded Plat \_\_\_\_\_  
5. Private Claims \_\_\_\_\_

I, William R. Byl, in a field survey on Sept. 16, 19 94, do hereby certify that under requirements of P.A. 74, Michigan P.A. of 1970, the corner points mentioned in lines 1 and 2 above were in conformance with regulations and rules therefore as required in the current manual of survey instructions of the United States Department of the Interior, Bureau of Land Management or by a decree of a Court of Law and/or that the corner points mentioned in lines 3, 4 and 5 above were in conformance with the rules of the Michigan Board of Land Surveyors or by a Decree of a Court of Law; established, re-established, monumented, re-monumented, recovered, found as expressed below:

**NOTE: Not more than 4 corners, all in the same town and range, may be recorded on this certificate.**

	A	B	C	D	E	F	G	H	I	J	K	L	M
2	6		5		4		3		2		1		
3													
4	7		8		9		10		11		12		
5													
6	18		17		16		15		14		13		
7													
8	19		20		21		22		23		24		
9													
10	30		29		28		27		26		25		
11													
12	31		32		33		34		35		36		
13													

**A. Description of original monument and accessories and/or subsequent restoration:**

- |     |      |            |           |                          |
|-----|------|------------|-----------|--------------------------|
| C-8 | 1831 | GLO        | Mullett   | Set Post                 |
|     | 1972 | LCRC #200  | Spicer    | Boat Spike               |
|     | 1981 | LCRC #2475 | Hackbardt | Set Kent County Monument |
|     | 1992 | LCRC #6500 | Bueche    | Kent County Monument     |

P.A. 345 1990 KENT COUNTY

PEER APPROVED 12/1/94  
CHAIRMAN Harry Huber

The position of this corner was previously approved by the Kent County Remonumentation Peer Group, monumented by Glen S. Hackbardt on 9/10/81 and was recorded per LCRC #2475

**B. Description of corner evidence found and/or method applied in restoring or reestablishing corner:**


C-8 Found standard Kent Co. Mon. (Harrison) per witnesses from above LCRC as set by Glen S. Hackbardt in place of the 1 1/4" Iron he found in a mon. box. Said 1 1/4" Iron in mon. box checks with LCRC #200

LCRC #2475			LCRC #6500		
C/L manhole	N45°W	59.26'	NW corner bldg. (brick)	N85°E	152.02'
NW cor. bldg.	N85°E	152.15'	SW corner bldg. (brick)	S60°E	139.11'
C/L manhole	N45°E	40.95'	SE corner conc. fdn.	N45°W	132.13'
C/L manhole	S40°E	80.85'	KC Remon. tag & nail SE side PP	N30°E	95.73'
C/L manhole	S55°W	84.70'	KC Remon. tag & nail W. side 14" Ch.	S40°W	80.99'
			C/L Bit. Rd. N-S is E. 9.5'; C/L Bit. Rd. W. is N. 35'		
			C/L Bit. Rd. E. is N. 49'		

The selected location is accepted by me and is generally accepted by professional surveyors as the best available evidence of the position of the original corner.

**C. Description of monument for corner and accessories established to perpetuate locating the position of the corner:**

- |   |       |         |
|---|-------|---------|
| C-8 Standard Kent County Monument       |       |         |
| NW corner bldg. (brick)                 | N85°E | 152.02' |
| SW corner bldg. (brick)                 | S60°E | 139.11' |
| SE corner conc. fdn.                    | N45°W | 132.20' |
| KC Remon. tag & nail SE side P. Pole    | N30°E | 95.76'  |
| KC Remon. tag & nail W. side 14" Cherry | S40°W | 81.03'  |
| C/L Bit. Rd. N-S is E. 9.5'             |       |         |
| C/L Bit. Rd. W. is N. 35'               |       |         |
| C/L Bit. Rd. E. is N. 49'               |       |         |

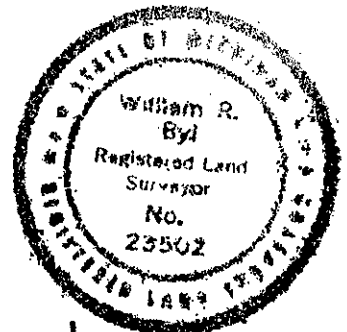

Signed by W. R. Byl Date 11/27/94  
Surveyor's Michigan License No. 23502