

SURVEY & REMONUMENTATION

KENT COUNTY REMONUMENTATION

APR 27 1995

LAND CORNER RECORDATION CERTIFICATE
Filing Requirement of Act 74, Mich. P.A. 1970

STATE OF MICHIGAN
COUNTY OF KENT
RECEIVED FOR RECORD
94 DEC -5 AM 8:55

For corners in **COMMISSION**
KENT COUNTY
(County)


	Located In:	Corner Code #
1. Public Land Survey	T <u>6N</u> R <u>11W</u>	<u>C-10</u>
	T _____ R _____	_____
	T _____ R _____	_____
	T _____ R _____	_____
2. Property Controlling in Section	S _____ T _____ R _____	_____
	S _____ T _____ R _____	_____
3. Miscellaneous Property in Sec.	S _____ T _____ R _____	_____
	S _____ T _____ R _____	_____

Luci J. Bond
REG. OF DEEDS

7621

Register of Deeds Stamp & File Number

- 4. Lot No. _____, Recorded Plat _____
- 5. Private Claims _____

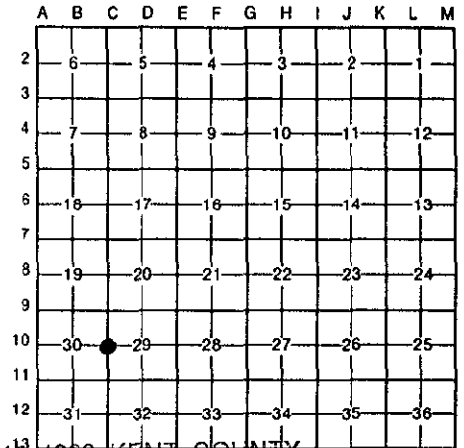

I, William R. Byl, in a field survey on Oct 12, 19 94, do hereby certify that under requirements of P.A. 74, Michigan P.A. of 1970, the corner points mentioned in lines 1 and 2 above were in conformance with regulations and rules therefore as required in the current manual of survey instructions of the United States Department of the Interior, Bureau of Land Management or by a decree of a Court of Law and/or that the corner points mentioned in lines 3, 4 and 5 above were in conformance with the rules of the Michigan Board of Land Surveyors or by a Decree of a Court of Law; established, re-established, monumented, re-monumented, recovered, found as expressed below:

NOTE: Not more than 4 corners, all in the same town and range, may be recorded on this certificate.

A. Description of original monument and accessories and/or subsequent restoration:

P.A. 345 1900 KENT COUNTY
PEER APPROVED 12/1/94
CHAIRMAN *Harry Huber*

C-10	1831	GLO	Mullett	Set Post
	1972	LCRC #362	Bonnema	PK Nail-Set 1/2" Iron
	1982	LCRC #2994	Byl	Set Kent County Monument
	1992	LCRC #6502	Bueche	Kent County Monument

The position of this corner was previously approved by the Kent County Remonumentation Peer Group, monumented by William R. Byl on 5/24/82 and was recorded per LCRC #2994

B. Description of corner evidence found and/or method applied in restoring or reestablishing corner:


C-10 Found standard Kent Co. Mon. (Harrison) per witnesses from above LCRC as set by William R. Byl in place of the 1/2" x 18" Iron Pipe he found. Said Iron Pipe checks with LCRC #362.

LCRC #2994		LCRC #6502	
SW cor. brick bldg.	N50°E 119.18'	SW cor. brick bldg.	N50°E 119.18'
SW cor. brick bldg.	N50°W 182.05'	SW cor. brick bldg.	N50°W 182.05'
NE cor. fnd. block bldg.	S55°W 110.03'	NE cor. fnd. block bldg.	S55°W 110.03'
		NW cor. brick hse.	S55°E 125.71'

The selected location is accepted by me and is generally accepted by professional surveyors as the best available evidence of the position of the original corner.

C. Description of monument for corner and accessories established to perpetuate locating the position of the corner:

C-10 Standard Kent County Monument	
SW cor. brick bldg.	N50°E 119.18'
NE cor. fnd. block bldg.	S55°W 110.03'
NW cor. brick hse.	N55°E 125.74'
Set Nail & KC Remon. tag SE side 24" Oak	S55°E 71.64'
C/L top hydrant	N65°W 64.00'
SE bolt Lt. Pole base	N35°W 92.26'
SW cor. bldg. (siding)	N45°W 163.27'

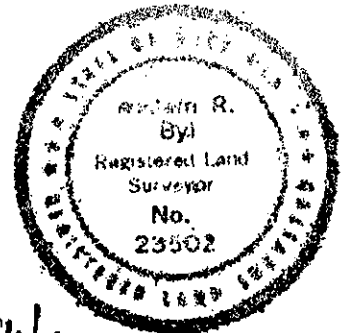

Signed by *W.R. Byl*
Surveyor's Michigan License No. 23502

Date 11/27/94