

SURVEY & REMONUMENTATION

APR 27 1995

KENT COUNTY REMONUMENTATION

COMMISSION

LAND CORNER RECORDATION CERTIFICATE
Filing Requirement of Act 74, Mich. P.A. 1970

STATE OF MICHIGAN
COUNTY OF KENT
RECEIVED FOR RECORD
94 DEC -5 AM 8:55

David Bond
REG. OF DEEDS

7622

Register of Deeds Stamp & File Number

For corners in
KENT COUNTY
(County)

	Located In:	Corner Code #
1. Public Land Survey	T <u>6N</u> R <u>11W</u>	<u>C-11</u>
	T _____ R _____	_____
	T _____ R _____	_____
	T _____ R _____	_____
2. Property Controlling in Section	S _____ T _____ R _____	_____
	S _____ T _____ R _____	_____
3. Miscellaneous Property in Sec.	S _____ T _____ R _____	_____
	S _____ T _____ R _____	_____

4. Lot No. _____, Recorded Plat _____
5. Private Claims _____

I, William R. Byl, in a field survey on Sept. 16, 19 94, do hereby certify that under requirements of P.A. 74, Michigan P.A. of 1970, the corner points mentioned in lines 1 and 2 above were in conformance with regulations and rules therefore as required in the current manual of survey instructions of the United States Department of the Interior, Bureau of Land Management or by a decree of a Court of Law and/or that the corner points mentioned in lines 3, 4 and 5 above were in conformance with the rules of the Michigan Board of Land Surveyors or by a Decree of a Court of Law; established, re-established, monumented, re-monumented, recovered, found as expressed below:

NOTE: Not more than 4 corners, all in the same town and range, may be recorded on this certificate.

	A	B	C	D	E	F	G	H	I	J	K	L	M
2	6		5		4		3		2		1		
3													
4	7		8		9		10		11		12		
5													
6	18		17		16		15		14		13		
7													
8	19		20		21		22		23		24		
9													
10	30		29		28		27		26		25		
11													
12	31		32		33		34		35		36		
13													

A. Description of original monument and accessories and/or subsequent restoration:

C-11	1831	GLO	Mullett	Set Post	P.A. 345 1990 KENT COUNTY
	1913-69	Williams & Works		Oak post-Iron	PEER APPROVED <u>12/1/94</u>
	1939	Kent Co. Wit.		Iron in blacktop	CHAIRMAN <i>Handwritten Signature</i>
	1964	CP Co.		Iron in C/L 52nd & Eastern	
	1984	LCRC #3770	Byl	Set Kent County Monument	
	1992	LCRC #6503	Bueche	Kent County Monument	

The position of this corner was previously approved by the Kent County Remonumentation Peer Group, monumented by William R. Byl on 2/15/84 and was recorded per LCRC #3770

B. Description of corner evidence found and/or method applied in restoring or reestablishing corner:


C-11 Found standard Kent Co. Mon. (Harrison) per witnesses from above LCRC as set by William R. Byl in place of the 3/4" x 24" Iron Pipe he found. Said Iron Pipe checks with Williams & Works, Kent Co. Wit. and CP Co.

LCRC #3770		LCRC #6503	
NW cor. brick ven. bldg.	S45°E 114.35'	Face hydrant at grade	N70°E 70.29'
Conc. Monument	N50°W 66.76'	NW cor. brick bldg.	S45°E 114.35'
Face hydrant (at grade)	N70°E 66.91'	Nail & KC Rem. tag E. sd. PP	S40°W 52.24'
Nail & tag E. sd. P.P.	N40°W 68.97'	C/L E. bolt sign base	N45°E 76.34'
Nail & tag W. sd. P.P.	N35°E 57.15'	Nail & KC Rem. tag N. sd. PP	N55°W 64.31'
Nail & tag E. sd. P.P.	S40°W 56.24'	Nail & KC Rem. tag S. sd. TP	S42°E 59.67'
		On C/L Bit. Rd. N-S & E-W	

The selected location is accepted by me and is generally accepted by professional surveyors as the best available evidence of the position of the original corner.

C. Description of monument for corner and accessories established to perpetuate locating the position of the corner:

C-11 Standard Kent County Monument			
Face hydrant at grade		N70°E	70.29'
NW cor. brick bldg.		S45°E	114.32'
Nail & KC Rem. tag E. sd. Guy Pole		S40°W	56.14'
C/L E. bolt sign base		N45°E	76.31'
Nail & KC Rem. tag N. sd. P. Pole		N55°W	64.35'
Nail & KC Rem. tag S. sd. Guy Pole		S42°E	59.67'
On C/L Bit. Rd. N-S & E-W			

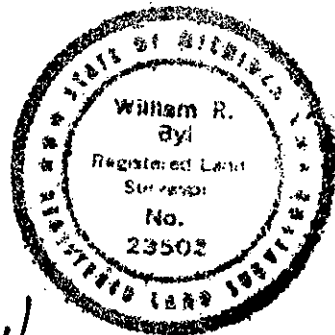

Signed by *William R. Byl*
Surveyor's Michigan License No. 23502

Date 11/27/94