

SURVEY & REMONUMENTATION

APR 27 1995

KENT COUNTY REMONUMENTATION

COMMISSION

LAND CORNER RECORDATION CERTIFICATE
Filing Requirement of Act 74, Mich. P.A. 1970

STATE OF MICHIGAN
COUNTY OF KENT
RECEIVED FOR RECORD
94 DEC -5 AM 8:55

For corners in
KENT COUNTY
(County)

Located In:	Corner Code #
T <u>6N</u> R <u>11W</u>	<u>C-13</u>
T _____ R _____	_____
T _____ R _____	_____
T _____ R _____	_____
T _____ R _____	_____
S _____ T _____ R _____	_____
S _____ T _____ R _____	_____
S _____ T _____ R _____	_____
S _____ T _____ R _____	_____

Tim Bond
REG. OF DEEDS

7624

Register of Deeds Stamp & File Number

4. Lot No. _____, Recorded Plat _____
5. Private Claims _____

	A	B	C	D	E	F	G	H	I	J	K	L	M
2	6	5	4	3	2	1							
3													
4	7	8	9	10	11	12							
5													
6	18	17	16	15	14	13							
7													
8	19	20	21	22	23	24							
9													
10	30	29	28	27	26	25							
11													
12	31	32	33	34	35	36							
13													

I, William R. Byl, in a field survey on Sept. 16, 19 94, do hereby certify that under requirements of P.A. 74, Michigan P.A. of 1970, the corner points mentioned in lines 1 and 2 above were in conformance with regulations and rules therefore as required in the current manual of survey instructions of the United States Department of the Interior, Bureau of Land Management or by a decree of a Court of Law and/or that the corner points mentioned in lines 3, 4 and 5 above were in compliance with the rules of the Michigan Board of Land Surveyors or by a Decree of a Court of Law; established, re-established, monumented, re-monumented, recovered, found as expressed below:

NOTE: Not more than 4 corners, all in the same town and range, may be recorded on this certificate.

A. Description of original monument and accessories and/or subsequent restoration:

C-13	1831	GLO	Mullett	Set Post
	1943	Kent Co. Wit.		Iron
	1973	LCRC #542	Spicer	Boat Spike
	1981	LCRC #1688	Merdzinski	Set Kent County Monument
	1988	LCRC #4907	Marschall	Reset Kent County Monument
	1992	LCRC #6505	Bueche	Kent County Monument

P.A. 345 1990 KENT COUNTY
PEER APPROVED 12/1/94
CHAIRMAN *Harry Hubers*

The position of this corner was previously approved by the Kent County Remonumentation Peer Group, monumented by John A. Merdzinski on 2/25/81 and was recorded per LCRC #1688

B. Description of corner evidence found and/or method applied in restoring or reestablishing corner:


C-13 Found standard Kent Co. Mon. (Harrison) per witnesses from above LCRC as reset by Chris Marschall from 1981 witnesses used by John A. Merdzinski when he set Kent Co. Mon. in place of the Boat Spike he found. Said Boat Spike checks with LCRC #542.

<u>LCRC #1688</u>	<u>LCRC #6505</u>
Nail & tag 14" Pine S55°W 62.28'	KC Remon. tag & nail SE side PP N55°E 68.96'
Nail & tag 12" Pine S70°W 107.33'	NE cor. hse. fnd. S60°E 183.76'
Nail & tag 24" Elm N75°W 132.88'	SW cor. hse. fnd. S40°E 164.77'
Nail & tag P. Pole N55°E 68.91'	Top C/L hydrant N40°W 56.36'
Nail & tag T. Pole S15°W 95.27'	NE cor. apartments S45°W 144.35'
Top C/L hydrant N40°W 50.36'	SE cor. Condo. N45°W 148.67'
NE cor. hse. S60°E 183.75'	SW cor. brick sign fnd. N45°E 121.87'
SW cor. hse. S40°E 164.78'	KC Mon. NE cor. Sec. 6, T5N, R11W West 29.03'

The selected location is accepted by me and is generally accepted by professional surveyors as the best available evidence of the position of the original corner.

C. Description of monument for corner and accessories established to perpetuate locating the position of the corner:

C-13 Standard Kent County Monument	
NE cor. hse. fnd.	S60°E 183.79'
SW cor. hse. fnd.	S40°E 164.77'
Top C/L hydrant	N40°W 56.86'
NE cor. apartments	S45°W 144.38'
SE cor. Condo.	N45°W 148.67'
SW cor. brick sign	N45°E 121.87'
KC Mon. NE cor. Sec. 6, T5N, R11W	S90°W 29.03'
On C/L Bit. Rd. E-W-S	

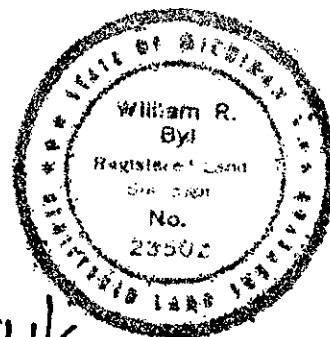

Signed by *W. R. Byl* Date 11/27/94

Surveyor's Michigan License No. 23502