

KENT COUNTY REMONUMENTATION

\$7.00
\$2.00

JAN 24 1996

COMMISSION

LAND CORNER RECORDATION CERTIFICATE
Filing Requirement of Act 74, Mich. P.A. 1970

For corners in
KENT COUNTY
(County)

Located In:

Corner Code #

1. Public Land Survey	T 6N R 11W	D-2
	T R	
	T R	
	T R	
2. Property Controlling in Section	S T R	
	S T R	
3. Miscellaneous Property in Section	S T R	
	S T R	

STATE OF MICHIGAN
COUNTY OF KENT
RECEIVED FOR RECORD
95 DEC 20 AM 8:38
REG. OF DEEDS
8799
Register of Deeds Stamp & File Number

- 4. Lot No. _____, Recorded Plat _____
- 5. Private Claims _____

A	B	C	D	E	F	G	H	I	J	K	L	M
2	6	5	4	3	2	1						
3												
4	7	8	9	10	11	12						
5												
6	18	17	16	15	14	13						
7												
8	19	20	21	22	23	24						
9												
10	30	29	28	27	26	25						
11												
12	31	32	33	34	35	36						
13												

I, Kirk Breitels, in a field survey on Nov. 17, 1994, do hereby certify that under requirements of P.A. 74, Michigan P.A. of 1970, the corner points mentioned in lines 1 and 2 above were in conformance with regulations and rules therefore as required in the current manual of survey instructions of the United States Department of the Interior, Bureau of Land Management or by a decree of a Court of Law and/or that the corner points mentioned in lines 3, 4 and 5 above were in conformance with the rules of the Michigan Board of Professional Surveyors or by a Decree of a Court of Law; established, re-established, monumented, re-monumented, recovered, found as expressed below:

NOTE: Not more than 4 corners, all in the same town and range, may be recorded on this certificate.

A. Description of original monument and accessories and/or subsequent restoration:

D-2	1831	GLO	Not Set
	1913-59	Williams & Works	City Iron
		Conc. Lt. Post SSE 53.0'	CP Pole ENE 33.3' C/L Hydr. WNW 41.5'
	1957	City of Grand Rapids	City Iron
	1985	William R. Byl, Inc.	City Iron

B. Description of corner evidence found and/or method applied in restoring or reestablishing corner:


D-2 Found City Iron, no witnesses remain from City of Grand Rapids or Williams & Works. City Iron fits adjoining plats and measurements by others. Said City Iron is 1.1' S. & 0.6' W. from true intersection of 1/4 lines.

The City Iron is accepted by me and is generally accepted by professional surveyors as the best available evidence of the position of the corner.

P.A. 345 1990 KENT COUNTY
PEER APPROVED 11/17/94
CHAIRMAN Harry Huber

C. Description of monument for corner and accessories established to perpetuate locating the position of the corner:

D-2	Set Standard Kent County Monument in place of the City Iron	
	NE corner brick bldg.	N65°W 76.54'
	SE corner brick bldg. (NE cor. entry)	S45°W 74.67'
	SW corner brick bldg.	N10°E 35.40'
	Set Nail & KC Remon. tag S. side P. Pole	N65°E 36.14'
	Set Nail & KC Remon. tag E. side P. Pole	S30°E 48.16'

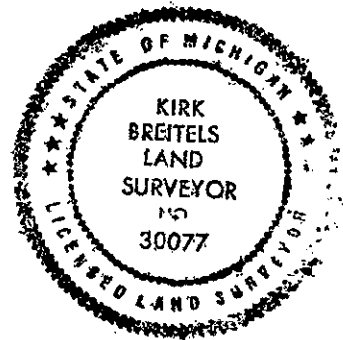

Signed by Kirk Breitels

Date 12/11/95

Surveyor's Michigan License No. 30077