

JAN 24 1996

KENT COUNTY REMONUMENTATION

\$7.00  
\$2.00

COMMISSION

LAND CORNER RECORDATION CERTIFICATE  
Filing Requirement of Act 74, Mich. P.A. 1970

For corners in  
KENT COUNTY  
(County)

Located In:

Corner Code #

1. Public Land Survey	T	6N	R	11W	D-8
	T		R		
	T		R		
	T		R		
2. Property Controlling in Section	S		T	R	
	S		T	R	
3. Miscellaneous Property in Section	S		T	R	
	S		T	R	

REG. OF DEEDS

*David Stand*

95 DEC 20 AM 8:40

STATE OF MICHIGAN  
COUNTY OF KENT  
RECEIVED FOR RECORD

8815

Register of Deeds Stamp & File Number

- 4. Lot No. \_\_\_\_\_, Recorded Plat \_\_\_\_\_
- 5. Private Claims \_\_\_\_\_

A	B	C	D	E	F	G	H	I	J	K	L
2	6	5	4	3	2	1					
3											
4	7	8	9	10	11	12					
5											
6	18	17	16	15	14	13					
7											
8	19	20	21	22	23	24					
9											
10	30	29	28	27	26	25					
11											
12	31	32	33	34	35	36					
13											

I, Kirk Breitels, in a field survey on Nov. 15, 1994, do hereby certify that under requirements of P.A. 74, Michigan P.A. of 1970, the corner points mentioned in lines 1 and 2 above were in conformance with regulations and rules therefore as required in the current manual of survey instructions of the United States Department of the Interior, Bureau of Land Management or by a decree of a Court of Law and/or that the corner points mentioned in lines 3, 4 and 5 above were in conformance with the rules of the Michigan Board of Professional Surveyors or by a Decree of a Court of Law; established, re-established, monumented, re-monumented, recovered, found as expressed below:

**NOTE: Not more than 4 corners, all in the same town and range, may be recorded on this certificate.**

**A. Description of original monument and accessories and/or subsequent restoration:**

D-8	1831	GLO	Not Set
	1913	Williams & Works	Fence corner
	1930-64	Williams & Works	Iron 24' N. of a monument
		Kent Co. Wits	Witnesses given - no desc. of corner
		Mon. S. 23.9' Mon. E. 19.5' MBT NNE 19.2'	
	1979	Exxel Eng.	Capped Moore & Bruggink Iron
	1985	Exxel Eng.	Concrete Monument

**B. Description of corner evidence found and/or method applied in restoring or reestablishing corner:**


D-8 Found a Concrete Monument (newer) that fits remaining Kent Co. Wit. and agrees with 1985 Exxel Eng. measurements and adjoining plats. Said Concrete Monument is 0.7' W. & less than 0.1' S. from true intersection of 1/4 lines.

The Concrete Monument is accepted by me and is generally accepted by professional surveyors as the best available evidence of the position of the corner.

P.A. 345 1990 KENT COUNTY  
PEER APPROVED 11/17/95  
CHAIRMAN Harry Huber

**C. Description of monument for corner and accessories established to perpetuate locating the position of the corner:**

D-8	Set Standard Kent County Monument in place of the Concrete Monument		
	Concrete Monument	S90°E	19.50'
	Set Nail & KC Remon. tag NW side P. Pole	N30°E	8.07'
	W'ly corner 6" square Light Pole	N40°W	30.04'
	C/L top of fire hydrant	S55°W	82.00
	C/L manhole	N65°W	54.70'

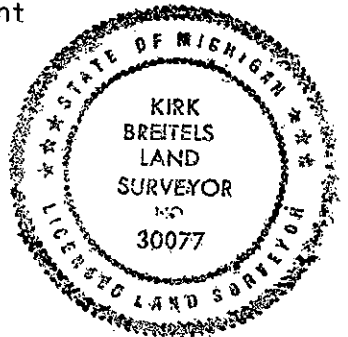

Signed by Kirk Breitels

Date 12/11/95

Surveyor's Michigan License No. 30077