

JAN 24 1996

KENT COUNTY REMONUMENTATION

\$7.00
\$2.00

COMMISSION

LAND CORNER RECORDATION CERTIFICATE

Filing Requirement of Act 74, Mich. P.A. 1970

For corners in
KENT COUNTY
(County)

Located In:

Corner Code #

1. Public Land Survey	T	6N	R	11W	D-10
	T		R		
	T		R		
	T		R		
2. Property Controlling in Section	S		T	R	
	S		T	R	
3. Miscellaneous	S		T	R	
Property in Section	S		T	R	

REG. OF DEEDS

8825

Register of Deeds Stamp & File Number

95 DEC 20 AM 8:40

STATE OF MICHIGAN
COUNTY OF KENT
RECEIVED FOR RECORD

- 4. Lot No. _____, Recorded Plat _____
- 5. Private Claims _____

A	B	C	D	E	F	G	H	I	J	K	L	M
2	6	5	4	3	2	1						
3												
4	7	8	9	10	11	12						
5												
6	18	17	16	15	14	13						
7												
8	19	20	21	22	23	24						
9												
10	30	29	28	27	26	25						
11												
12	31	32	33	34	35	36						
13												

I, Kirk Breitels, in a field survey on Nov. 15, 1994

do hereby certify that under requirements of P.A. 74, Michigan P.A. of 1970, the corner points mentioned in lines 1 and 2 above were in conformance with regulations and rules therefore as required in the current manual of survey instructions of the United States Department of the Interior, Bureau of Land Management or by a decree of a Court of Law and/or that the corner points mentioned in lines 3, 4 and 5 above were in conformance with the rules of the Michigan Board of Professional Surveyors or by a Decree of a Court of Law; established, re-established, monumented, re-monumented, recovered, found as expressed below:

NOTE: Not more than 4 corners, all in the same town and range, may be recorded on this certificate.

A. Description of original monument and accessories and/or subsequent restoration:

D-10 1831 GLO Not Set 1913-29 Williams & Works Iron
 1947-55 Williams & Works Set Iron on N-S 1/4 line, 20.65' E. of prev. iron
 8" Oak SE 14.4' 8" Oak NE 11.2 T. Pole SW 22.4' Iron W. 20.65'
 1963 Kent Co. Wit Iron
 12" Maple N. 38.25' 10" Maple NNE 49.60' 14" Maple NE 37.81'
 28" Maple SW 60.39' 20" Oak WSW 52.15' SW cor. hse. N. 49.60'
 1980 LCRC #1351 Bonnema 3/4" Iron
 P. Pole S. 31.78' NE cor. hse. fnd. SW 76.94'
 SE cor. hse. fnd. NNW 82.52' SW cor. hse. fnd. NE 86.11'

B. Description of corner evidence found and/or method applied in restoring or reestablishing corner:


D-10 Found 3/4" Iron Pipe that fits remaining 1947 Williams & Works and LCRC #1351 witnesses. No Kent Co. Wit. remain. Said Iron Pipe fits adjoining plat measurements and is 1.1' N. & 0.3' E. from a true intersection of 1/4 lines.

The 3/4" Iron Pipe is accepted by me and is generally accepted by professional surveyors as the best available evidence of the position of the corner.

P.A. 945 1990 KENT COUNTY
PEER APPROVED 11/17/94
CHAIRMAN [Signature]

C. Description of monument for corner and accessories established to perpetuate locating the position of the corner:

D-10 Set Standard Kent County Monument in place of the 3/4" Iron Pipe
 Set Nail & KC Remon. tag E. side P. Pole S00°E 31.80'
 NE corner house foundation S45°W 76.92'
 SE corner house foundation N10°W 82.55'
 SW corner house foundation N45°E 86.11'
 Iron under pavement - West 20.7'±

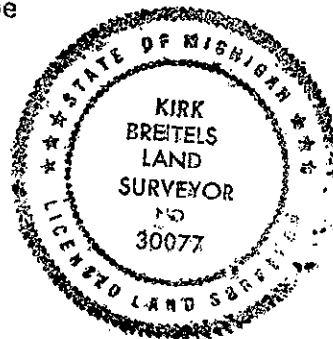

Signed by [Signature]

Date 12/11/95

Surveyor's Michigan License No. 30077