

SURVEY & REMONUMENTATION

APR 27 1995

KENT COUNTY REMONUMENTATION

COMMISSION

LAND CORNER RECORDATION CERTIFICATE
Filing Requirement of Act 74, Mich. P.A. 1970

STATE OF MICHIGAN
COUNTY OF KENT
RECEIVED FOR RECORD

94 DEC -5 AM 8:56

Luigi J. Bond
REG. OF DEEDS

For corners in
KENT COUNTY
(County)

	Located In:	Corner Code #
1. Public Land Survey	T <u>6N</u> R <u>11W</u>	<u>D-13</u>
	T _____ R _____	_____
	T _____ R _____	_____
	T _____ R _____	_____
2. Property Controlling in Section	S _____ T _____ R _____	_____
	S _____ T _____ R _____	_____
3. Miscellaneous Property in Sec.	S _____ T _____ R _____	_____
	S _____ T _____ R _____	_____

7631

Register of Deeds Stamp & File Number

4. Lot No. _____, Recorded Plat _____
5. Private Claims _____

I, William R. Byl, in a field survey on July 7, 19 94, do hereby certify that under requirements of P.A. 74, Michigan P.A. of 1970, the corner points mentioned in lines 1 and 2 above were in conformance with regulations and rules therefore as required in the current manual of survey instructions of the United States Department of the Interior, Bureau of Land Management or by a decree of a Court of Law and/or that the corner points mentioned in lines 3, 4 and 5 above were in conformance with the rules of the Michigan Board of Land Surveyors or by a Decree of a Court of Law; established, re-established, monumented, re-monumented, recovered, found as expressed below:

NOTE: Not more than 4 corners, all in the same town and range, may be recorded on this certificate.

	A	B	C	D	E	F	G	H	I	J	K	L	M
2	6	5	4	3	2	1							
3													
4	7	8	9	10	11	12							
5													
6	18	17	16	15	14	13							
7													
8	19	20	21	22	23	24							
9													
10	30	29	28	27	26	25							
11													
12	31	32	33	34	35	36							
13													

A. Description of original monument and accessories and/or subsequent restoration:

P.A. 345 1990 KENT COUNTY

D-13	1831	GLO	Mullett	Set Post	PEER APPROVED
	1973	LCRC #434	VanKooten	1/2" Iron	CHAIRMAN <i>Harry Huber</i>
	1981	LCRC #1687	Merdzinski	Set Kent County Monument	
	1992	LCRC #6511	Bueche	Kent County Monument	

The position of this corner was previously approved by the Kent County Remonumentation Peer Group, monumented by John A. Merdzinski on 2/25/81 and was recorded per LCRC #1687

B. Description of corner evidence found and/or method applied in restoring or reestablishing corner:

D-13 Found standard Kent Co. Mon. (Harrison) per witnesses from above LCRC as set by John A. Merdzinski in place of the 1/2" x 18" Iron inside a 1 1/2" x 24" Iron he found. Said Irons checks with LCRC #434.

LCRC #1687

LCRC #6511


Nail & tag 8" Ash	S20°E	26.03'	S'y cor. bldg. fnd.	N25°E	95.50'
Nail & tag 24" Oak	S70°E	62.19'	SE cor. hse. #1161 (frame)	N35°W	141.10'
S'y cor. bldg. fnd.	N25°E	95.50'	PK in W. side 6"-12" Maples	S35°E	65.15'
NW'y cor. bldg. fnd.	N10°E	110.65'	PK in W. side 12" Ch. Elm	S20°E	44.47'
SE cor. gar. fnd. #1161	N35°W	141.77'	NW'y cor. bldg. fnd.	N10°E	110.65'
NW cor. hse. fnd. #1190	S40°W	106.58'	NW cor. hse. fnd. #1190	S40°W	106.58' slope
Iron East 20.49'			C/L Bit. Rd. E-W 4' m/l N.		
C/L Blktp Rd. E-W is N. 4'			KC Mon. (N 1/4 Sec. 5, 5-11) East	20.49'	

The selected location is accepted by me and is generally accepted by professional surveyors as the best available evidence of the position of the original corner.

C. Description of monument for corner and accessories established to perpetuate locating the position of the corner:

D-13 Standard Kent County Monument

S'y cor. bldg. fnd.	N25°E	95.50'
SE cor. hse. #1161 (frame)	N35°W	141.40'
Set Nail & KC Remon. tag W. side 6"-12" Maples	S35°E	65.18'
Set Nail & KC Remon. tag W. side 12" Ch. Elm	S20°E	44.38'
NW'y cor. bldg. fnd.	N10°E	110.65'
NW cor. hse. fnd. #1190	S40°W	106.58'
KC Mon. (N 1/4 Cor. Sec. 5, T5N, R11W)	S90°E	20.49'
C/L Bit. Rd. E-W 4' m/l N.		

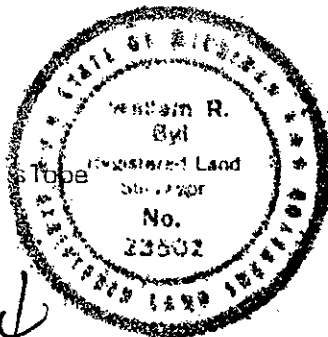

Signed by *W.R. Byl* Date 112794
Surveyor's Michigan License No. 23502