

# SURVEY & REMONUMENTATION

KENT COUNTY REMONUMENTATION

APR 27 1995

COMMISSION

**LAND CORNER RECORDATION CERTIFICATE**  
Filing Requirement of Act 74, Mich. P.A. 1970

STATE OF MICHIGAN  
COUNTY OF KENT  
RECEIVED FOR RECORD

94 DEC -5 AM 8:56

*Lucy Bond*  
REG. OF DEEDS

For corners in  
KENT COUNTY  
(County)

	Located In:	Corner Code #
1. Public Land Survey	T <u>6N</u> R <u>11W</u>	<u>E-1</u>
	T _____ R _____	_____
	T _____ R _____	_____
	T _____ R _____	_____
2. Property Controlling in Section	S _____ T _____ R _____	_____
	S _____ T _____ R _____	_____
3. Miscellaneous Property in Sec.	S _____ T _____ R _____	_____
	S _____ T _____ R _____	_____

7632

Register of Deeds Stamp & File Number

4. Lot No. \_\_\_\_\_, Recorded Plat \_\_\_\_\_  
5. Private Claims \_\_\_\_\_

	A	B	C	D	E	F	G	H	I	J	K	L	M
2	6		5		4		3		2		1		
3													
4	7		8		9		10		11		12		
5													
6	10		17		16		15		14		13		
7													
8	19		20		21		22		23		24		
9													
10	30		29		28		27		26		25		
11													
12	31		32		33		34		35		36		
13													

I, William R. Byl, in a field survey on July 7, 19 94, do hereby certify that under requirements of P.A. 74, Michigan P.A. of 1970, the corner points mentioned in lines 1 and 2 above were in conformance with regulations and rules therefore as required in the current manual of survey instructions of the United States Department of the Interior, Bureau of Land Management or by a decree of a Court of Law and/or that the corner points mentioned in lines 3, 4 and 5 above were in conformance with the rules of the Michigan Board of Land Surveyors or by a Decree of a Court of Law; established, re-established, monumented, re-monumented, recovered, found as expressed below:

**NOTE: Not more than 4 corners, all in the same town and range, may be recorded on this certificate.**

**A. Description of original monument and accessories and/or subsequent restoration:**

E-1	1831 GLO	Mullett	Set Post	P.A. 345 1990 KENT COUNTY
	1910-40 Williams & Works		City Iron	PEER APPROVED, 12/1/94
	1929 City of Grand Rapids		City Iron	CHAIRMAN <i>Harry Huber</i>
	1979 LCRC #3461	Bonnema	City Iron	
	1985 LCRC #4264	Byl	Set Kent County Monument	
	1988 LCRC #4674	Bueche	Kent County Monument	

The position of this corner was previously approved by the Kent County Remonumentation Peer Group, monumented by William R. Byl on 1/10/85 and was recorded per LCRC #4264

**B. Description of corner evidence found and/or method applied in restoring or reestablishing corner:**

E-1 Found standard Kent Co. Mon. (Harrison) per witnesses from above LCRC as set by William R. Byl in place of the City Iron he found. Said City Iron checks with Williams & Works, City of Grand Rapids and LCRC #3461.

<u>LCRC #4264</u>		<u>LCRC #4674</u>
NE cor. fnd. Hse. #1600	S35°E 85.86'	same witnesses as LCRC #4264
SW cor. fnd. Hse. #1154	N15°E 57.33'	
Face of hydr. jacket	S70°W 57.67'	
C/L City benchmark #212	N35°W 28.58'	
Kent Co. Mon.	N90°E 54.58'	


The selected location is accepted by me and is generally accepted by professional surveyors as the best available evidence of the position of the original corner.

**C. Description of monument for corner and accessories established to perpetuate locating the position of the corner:**

E-1 Standard Kent County Monument

NE cor. fnd. Hse. #1600	S35°E	85.95'
SW cor. fnd. Hse. #1154	N15°E	57.43'
Face of hydrant jacket (at grade)	S70°W	57.68'
C/L City benchmark #212	N35°W	28.58'
KC Mon. (SE cor. Sec. 32, T7N, R11W)	N90°E	54.65'

Cor. is 29' E. of Sylvan Ave. to South

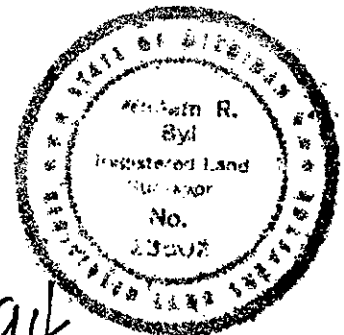

Signed by *W.R. Byl* Date 11/27/94  
Surveyor's Michigan License No. 23502