

SURVEY & REMONUMENTATION

APR 27 1995

KENT COUNTY REMONUMENTATION

LAND CORNER RECORDATION CERTIFICATE Filing Requirement of Act 74, Mich. P.A. 1970

STATE OF MICHIGAN
COUNTY OF KENT
RECEIVED FOR RECORD
94 DEC -5 AM 8:56

Lucy Bond
REG. OF DEEDS

7633

Register of Deeds Stamp & File Number

COMMISSION
For corners in
KENT COUNTY
(County)

	Located In:	Corner Code #
1. Public Land Survey	T <u>6N</u> R <u>11W</u>	<u>E-2</u>
	T _____ R _____	_____
	T _____ R _____	_____
	T _____ R _____	_____
2. Property Controlling in Section	S _____ T _____ R _____	_____
	S _____ T _____ R _____	_____
3. Miscellaneous Property in Sec.	S _____ T _____ R _____	_____
	S _____ T _____ R _____	_____

4. Lot No. _____, Recorded Plat _____
5. Private Claims _____

I, William R. Byl, in a field survey on July 7, 19 94, do hereby certify that under requirements of P.A. 74, Michigan P.A. of 1970, the corner points mentioned in lines 1 and 2 above were in conformance with regulations and rules therefore as required in the current manual of survey instructions of the United States Department of the Interior, Bureau of Land Management or by a decree of a Court of Law and/or that the corner points mentioned in lines 3, 4 and 5 above were in conformance with the rules of the Michigan Board of Land Surveyors or by a Decree of a Court of Law; established, re-established, monumented, re-monumented, recovered, found as expressed below:

NOTE: Not more than 4 corners, all in the same town and range, may be recorded on this certificate.

	A	B	C	D	E	F	G	H	I	J	K	L	M
2	6		5	4	3	2	1						
3													
4	7	8	9	10	11	12							
5													
6	18	17	16	15	14	13							
7													
8	19	20	21	22	23	24							
9													
10	30	29	28	27	26	25							
11													
12	31	32	33	34	35	36							
13													

A. Description of original monument and accessories and/or subsequent restoration:

P.A. 345 1980 KENT COUNTY
PEER APPROVED 12/1/94
CHAIRMAN *Harry Huker*

E-2	1831	GLO	Mullett	Set Post
	1914-52	Williams & Works		City Iron
	1920	City of Grand Rapids		City Iron
	1985	LCRC #4260	Byl	Set Kent County Monument
	1992	LCRC #6512	Bueche	Kent County Monument

The position of this corner was previously approved by the Kent County Remonumentation Peer Group, monumented by William R. Byl on 5/24/85 and was recorded per LCRC #4260

B. Description of corner evidence found and/or method applied in restoring or reestablishing corner:


E-2 Found standard Kent Co. Mon. (Harrison) per witnesses from above LCRC as set by William R. Byl in place of the City Iron he found. Said City Iron checks with Williams & Works and City of Grand Rapids.

<u>LCRC #4260</u>	<u>LCRC #6512</u>
SE cor. brk. veneer hse.	same witnesses as LCRC #4260
4' above grade	N35°W 84.16'
SW cor. fnd. hse.	N40°E 76.96'
NW cor. fnd. hse.	S45°E 94.45'
Nail & tag P. Pole	S25°W 39.45'
Face of hydr. jacket	N65°E 46.29'

The selected location is accepted by me and is generally accepted by professional surveyors as the best available evidence of the position of the original corner.

C. Description of monument for corner and accessories established to perpetuate locating the position of the corner:

E-2 Standard Kent County Monument	
SE cor. brk. veneer hse. 4' above grade	N35°W 84.16'
SW cor. fnd. hse. #1603, at grade	N40°E 76.91'
NW cor. fnd. hse. #1600 (not porch)	S45°E 94.47'
Nail & KC Remon.tag E. side P. Pole	S25°W 39.45'
Face of hydrant jacket at grade	N65°E 46.29'

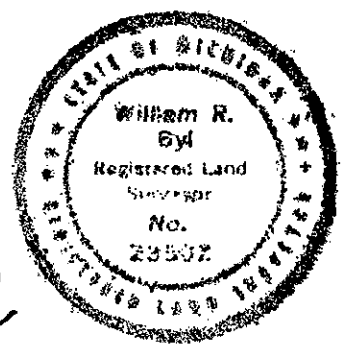

Signed by *W. R. Byl* Date 11/27/94
Surveyor's Michigan License No. 23502