

SURVEY & REMONUMENTATION

KENT COUNTY REMONUMENTATION

STATE OF MICHIGAN
COUNTY OF KENT
RECEIVED FOR RECORD

APR 27 1995

LAND CORNER RECORDATION CERTIFICATE
Filing Requirement of Act 74, Mich. P.A. 1970

94 DEC -5 AM 8:56

COMMISSION

For corners in
KENT COUNTY

(County)	Located In:	Corner Code #
1. Public Land Survey	T <u>6N</u> R <u>11W</u>	<u>E-3</u>
	T _____ R _____	_____
	T _____ R _____	_____
	T _____ R _____	_____
2. Property Controlling in Section	S _____ T _____ R _____	_____
	S _____ T _____ R _____	_____
3. Miscellaneous Property in Sec.	S _____ T _____ R _____	_____
	S _____ T _____ R _____	_____


W. J. Bond
REG. OF DEEDS

7634

Register of Deeds Stamp & File Number

4. Lot No. _____, Recorded Plat _____
5. Private Claims _____

I, William R. Byl, in a field survey on July 11, 19 94, do hereby certify that under requirements of P.A. 74, Michigan P.A. of 1970, the corner points mentioned in lines 1 and 2 above were in conformance with regulations and rules therefore as required in the current manual of survey instructions of the United States Department of the Interior, Bureau of Land Management or by a decree of a Court of Law and/or that the corner points mentioned in lines 3, 4 and 5 above were in conformance with the rules of the Michigan Board of Land Surveyors or by a Decree of a Court of Law; established, re-established, monumented, re-monumented, recovered, found as expressed below:

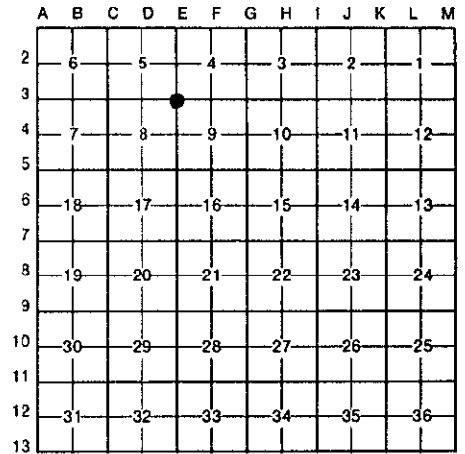

NOTE: Not more than 4 corners, all in the same town and range, may be recorded on this certificate.

A. Description of original monument and accessories and/or subsequent restoration:

E-3	1831	GLO	Mullett	Set Post
	1910-68	Williams & Works		City Iron-Point on manhole
	1931-57	City of Grand Rapids		Point on manhole
	1933	Kent Co. Wit.		Manhole cover
	1984	LCRC #3768	Byl	Set Point on manhole cover
	1992	LCRC #6513	Bueche	Point on manhole cover

The position of this corner was previously approved by the Kent County Remonumentation Peer Group, monumented (no Kent Co. Mon. set) by William R. Byl on 2/14/84 and was recorded per LCRC #3768

B. Description of corner evidence found and/or method applied in restoring or reestablishing corner:

E-3 Established Point on manhole cover per witnesses from above LCRC as set by William R. Byl and street improvements. Said Point on manhole checks with Williams & Works and City of Grand Rapids and Kent Co. Wit.


<u>LCRC #3768</u>		<u>LCRC #6513</u>	
Stone cor. brick hse.	N30°W 86.15'	same witnesses as LCRC #3768	
SW cor. fnd. hse.	N40°E 89.90'		
Nail & tag traffic signal pole	S40°W 59.09'		
Nail & tag traffic signal pole	S40°E 54.92'		

P.A. 345 1990 KENT COUNTY
PEER APPROVED 12/11/94
CHAIRMAN *Harry Huber*

The selected location is accepted by me and is generally accepted by professional surveyors as the best available evidence of the position of the original corner.

C. Description of monument for corner and accessories established to perpetuate locating the position of the corner:

E-3 Point on manhole cover		
Stone corner brick house	N30°W	86.12'
SW corner foundation house	N40°E	89.93'
Nail & KC Remon. tag E. side traffic signal pole	S40°W	59.03'
Nail & KC Remon. tag W. side traffic signal pole	S40°E	54.92'
Cut on manhole frame N-S & E-W		

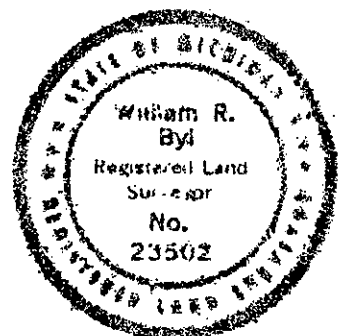

Signed by *W. R. Byl*
Surveyor's Michigan License No. 23502

Date 11/27/94