

# SURVEY & REMONUMENTATION

KENT COUNTY REMONUMENTATION

APR 27 1995

## LAND CORNER RECORDATION CERTIFICATE

**COMMISSION** Filing Requirement of Act 74, Mich. P.A. 1970

For corners in  
KENT COUNTY

(County)	Located In:	Corner Code #	
1. Public Land Survey	T 6N R 11W	E-7	
	T _____ R _____		
	T _____ R _____		
	T _____ R _____		
2. Property Controlling in Section	S _____ T _____ R _____		
	S _____ T _____ R _____		
3. Miscellaneous Property in Sec.	S _____ T _____ R _____		
	S _____ T _____ R _____		
4. Lot No. _____, Recorded Plat _____			
5. Private Claims _____			

STATE OF MICHIGAN  
COUNTY OF KENT  
RECEIVED FOR RECORD  
94 DEC -5 AM 8:56

*Tim J. Bond*  
REG. OF DEEDS

7638

Register of Deeds Stamp & File Number


I, William R. Byl, in a field survey on Sept. 14, 19 94, do hereby certify that under requirements of P.A. 74, Michigan P.A. of 1970, the corner points mentioned in lines 1 and 2 above were in conformance with regulations and rules therefore as required in the current manual of survey instructions of the United States Department of the Interior, Bureau of Land Management or by a decree of a Court of Law and/or that the corner points mentioned in lines 3, 4 and 5 above were in conformance with the rules of the Michigan Board of Land Surveyors or by a Decree of a Court of Law; established, re-established, monumented, re-monumented, recovered, found as expressed below:

**NOTE: Not more than 4 corners, all in the same town and range, may be recorded on this certificate.**

**A. Description of original monument and accessories and/or subsequent restoration:**

E-7	1831	GLO	Mullett	Set Post
		Williams & Works		"x" cut in pavement
	1959	Kent Co. Wit.		Iron in mon. box
	1983	LCRC #3225	Bonnema	Set RR Spike from plat dimensions (Corrects LCRC #1038)
	1984	LCRC #3741	Byl	Set Kent County Monument
	1992	LCRC #6517	Bueche	Reset Kent County Monument after const.

P.A. 345 1900 KENT COUNTY  
PEER APPROVED 12/11/94  
CHAIRMAN *Frank Huber*

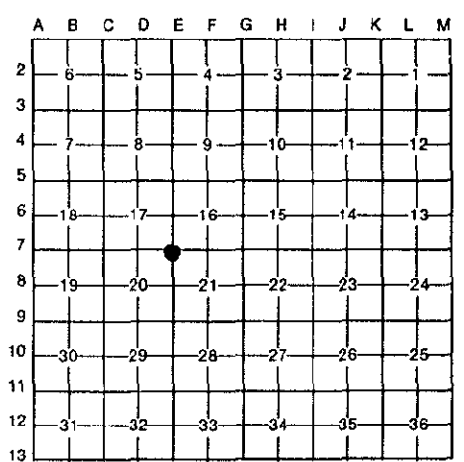

The position of this corner was previously approved by the Kent County Remonumentation Peer Group, monumented by William R. Byl on 2/20/84 and was recorded per LCRC #3741

**B. Description of corner evidence found and/or method applied in restoring or reestablishing corner:**

E-7 Found standard Kent Co. Mon. (Harrison) per witnesses from above LCRC as set by John C. Bueche in same location as set in 1984 by William R. Byl in place of the RR Spike he found. Said RR Spike checks with LCRC #3225.

<u>LCRC #3741</u>	<u>LCRC #6517</u>
Nail & tag Guy Pole N45°E 30.89'	NW cor. stone pillar of sign 2.85' above ground
Nail & tag MBT Pole S60°E 41.72'	(4th layer) N40°E 88.71'
Nail & tag CP Pole S55°W 49.66'	SE cor. hse. fnd. N40°W 126.63'
Cor. of hse. fnd. N40°W 126.63'	SW cor. brick veneer of church S45°E 126.50'
SW cor. brick veneer of church bldg. S45°E 126.50'	Conc. nail E. side 16" Ash N10°E 191.53'
	Conc. nail & KC tag in curb joint N20°W 99.29'
	Nail & KC tag NW side P. Pole S55°W 55.63'
	"x" cut on E. rim of Bell MH East 43.61'

The selected location is accepted by me and is generally accepted by professional surveyors as the best available evidence of the position of the original corner.

**C. Description of monument for corner and accessories established to perpetuate locating the position of the corner:**

E-7 Standard Kent County Monument	
NW cor. stone pillar of sign 2.85' above ground (4th layer)	N40°E 88.63'
SE cor. hse. fnd.	N40°W 126.63'
SW cor. brick veneer of church	S45°E 126.50'
Set Nail & KC Remon. tag E. side 20" Ash	N10°E 191.60'
Conc. nail & KC tag in curb joint	N20°W 99.29'
Nail & KC Remon. tag NW side P. Pole	S55°W 55.66'
"x" cut on E. rim of MBT Manhole	S90°E 43.57'

Signed by *W. R. Byl*  
Surveyor's Michigan License No. 23502

Date 11/27/94

