

**SURVEY & REMONUMENTATION**

APR 27 1995

KENT COUNTY REMONUMENTATION

STATE OF MICHIGAN  
COUNTY OF KENT  
RECEIVED FOR RECORD

**COMMISSION**

**LAND CORNER RECORDATION CERTIFICATE** 94 DEC -5 AM 8:56  
Filing Requirement of Act 74, Mich. P.A. 1970

For corners in  
KENT COUNTY  
(County)

Located In: Corner Code #


- |                                    |   |    |   |     |     |
|------------------------------------|---|----|---|-----|-----|
| 1. Public Land Survey              | T | 6N | R | 11W | E-9 |
|                                    | T |    | R |     |     |
|                                    | T |    | R |     |     |
|                                    | T |    | R |     |     |
| 2. Property Controlling in Section | S |    | T | R   |     |
|                                    | S |    | T | R   |     |
| 3. Miscellaneous Property in Sec.  | S |    | T | R   |     |
|                                    | S |    | T | R   |     |

*Levi J. Bond*  
REG. OF DEEDS

7640

Register of Deeds Stamp & File Number

4. Lot No. \_\_\_\_\_, Recorded Plat \_\_\_\_\_  
5. Private Claims \_\_\_\_\_

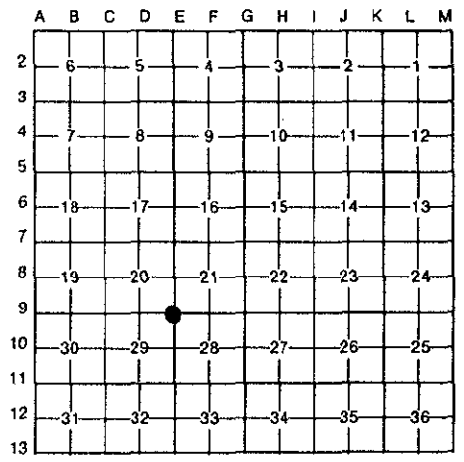

I, William R. Byl, in a field survey on Sept. 13, 19 94, do hereby certify that under requirements of P.A. 74, Michigan P.A. of 1970, the corner points mentioned in lines 1 and 2 above were in conformance with regulations and rules therefore as required in the current manual of survey instructions of the United States Department of the Interior, Bureau of Land Management or by a decree of a Court of Law and/or that the corner points mentioned in lines 3, 4 and 5 above were in conformance with the rules of the Michigan Board of Land Surveyors or by a Decree of a Court of Law; established, re-established, monumented, re-monumented, recovered, found as expressed below:

**NOTE: Not more than 4 corners, all in the same town and range, may be recorded on this certificate.**

**A. Description of original monument and accessories and/or subsequent restoration:**

E-9	1831	GLO	Mullett	Set Post	P.A. 345 1990 KENT COUNTY
	1956	Kent Co. Wit.		Mon. Box	PEER APPROVED 12/11/94
	1971	LCRC #50	Spicer	Mon. Box	CHAIRMAN <i>Harry Thibodeau</i>
	1987	LCRC #4522	Tobin	Set Kent County Monument in mon. box	
	1992	LCRC #6519	Bueche	Kent County Monument in mon. box	

The position of this corner was previously approved by the Kent County Remonumentation Peer Group, monumented by Douglas J. Tobin on 9/19/87 and was recorded per LCRC #4522

**B. Description of corner evidence found and/or method applied in restoring or reestablishing corner:**

E-9 Found standard Kent Co. Mon. (Harrison) per witnesses from above LCRC as set by Douglas J. Tobin in place of the Iron he found in a mon. box. Said Iron in mon. box checks with Kent Co. Wit. & LCRC #50.

<u>LCRC #4522</u>	<u>LCRC #6519</u>
"X" cut SE bolt base RR signal base N40°W 84.30'	"X" cut top center SE bolt to base of RR signal pole N40°W 84.30'
"X" cut NE bolt to E. RR signal base S55°W 92.43'	"X" cut top center NE bolt to E. RR signal pole base S55°W 92.43'
Nail & tag Tel. Pole S45°E 69.31'	Nail & KC tag SW side Tel. Pole S45°E 69.24'
S'yly cor. 1.5' sq. Lt. Pole base N35°E 108.89'	S'yly cor. 1.5' sq. conc. LP base N35°E 108.89'
	"X" cut SW side conc. S50°E 82.85'
	C/L Bit. Rd. N-S & E-W

The selected location is accepted by me and is generally accepted by professional surveyors as the best available evidence of the position of the original corner.

**C. Description of monument for corner and accessories established to perpetuate locating the position of the corner:**

E-9 Standard Kent County Monument in mon. box	
"X" cut top center SE bolt to base of RR signal pole	N40°W 84.28'
"X" cut top center NE bolt to E. RR signal pole base	S55°W 92.43'
Nail & KC Remon. tag SW side Tel. Pole	S45°E 69.26'
S'yly cor. 1.5' x 1.5' conc. Lt. Pole base	N35°E 108.89'
"X" cut SW side conc. (W'yly leg for sign)	S50°E 82.82'
Most N'yly bolt Lt. Pole base	S30°W 103.38'
C/L top of hydrant	N50°W 77.0'
C/L Bit. Rd. N-S & E-W	

Signed by *William R. Byl*  
Surveyor's Michigan License No. 23502

Date 11/27/94

