

SURVEY & REMONUMENTATION

KENT COUNTY REMONUMENTATION

APR 27 1995

LAND CORNER RECORDATION CERTIFICATE
Filing Requirement of Act 74, Mich. P.A. 1970

STATE OF MICHIGAN
COUNTY OF KENT
RECEIVED FOR RECORD
94 DEC -5 AM 8:56

For corners in **COMMISSION**
KENT COUNTY

Wm R. Byl
REG. OF DEEDS

(County)	Located In:	Corner Code #
1. Public Land Survey	T <u>6N</u> R <u>11W</u>	<u>E-10</u>
	T _____ R _____	_____
	T _____ R _____	_____
	T _____ R _____	_____
2. Property Controlling in Section	S _____ T _____ R _____	_____
	S _____ T _____ R _____	_____
3. Miscellaneous Property in Sec.	S _____ T _____ R _____	_____
	S _____ T _____ R _____	_____

7641

Register of Deeds Stamp & File Number

4. Lot No. _____, Recorded Plat _____
5. Private Claims _____

	A	B	C	D	E	F	G	H	I	J	K	L	M
2	6	5	4	3	2	1							
3													
4	7	8	9	10	11	12							
5													
6	18	17	16	15	14	13							
7													
8	19	20	21	22	23	24							
9													
10	30	29	28	27	26	25							
11													
12	31	32	33	34	35	36							
13													

I, William R. Byl, in a field survey on Sept. 21, 19 94

do hereby certify that under requirements of P.A. 74, Michigan P.A. of 1970, the corner points mentioned in lines 1 and 2 above were in conformance with regulations and rules therefore as required in the current manual of survey instructions of the United States Department of the Interior, Bureau of Land Management or by a decree of a Court of Law and/or that the corner points mentioned in lines 3, 4 and 5 above were in conformance with the rules of the Michigan Board of Land Surveyors or by a Decree of a Court of Law; established, re-established, monumented, re-monumented, recovered, found as expressed below:

NOTE: Not more than 4 corners, all in the same town and range, may be recorded on this certificate.

A. Description of original monument and accessories and/or subsequent restoration:

E-10	1831	GLO	Mullett	Set Post
	1963	Kent Co. Wit.		Iron in mon. box
	1974	LCRC #622	South	1/2" rebar in mon. box
	1982	LCRC #2999	Byl	Set Kent County Monument in mon. box
	1992	LCRC #6520	Bueche	Kent County Monument

P.A. 345 1990 KENT COUNTY
PEER APPROVED 12/1/94
CHAIRMAN Wm R. Byl

The position of this corner was previously approved by the Kent County Remonumentation Peer Group, monumented by William R. Byl on 5/20/82 and was recorded per LCRC #2999

B. Description of corner evidence found and/or method applied in restoring or reestablishing corner:


E-10 Found standard Kent Co. Mon. (Harrison) per witnesses from above LCRC as set by William R. Byl in place of the 3/4" Iron he found over a 1" Iron inside a mon box. Said Irons checks with Kent County Wit. and LCRC #622.

LCRC #2999		LCRC #6520	
Nail & tag P. Pole	N60°W 48.39'	KC tag & nail S. side P. Pole	N60°W 48.39'
Nail & tag Guy Pole	N60°E 40.96'	KC tag & nail N. side Guy Pole	N60°E 48.96'
SE cor. brk. gar. #4785	N55°W 120.88'	SE cor. brick garage hse. #4785	N55°W 120.88'
1/2" rebar (EXXEL)	N90°E 50.06'	NE cor. brick hse. #4785	N40°W 165.61'
		NE cor. garage siding	S60°W 119.56'
		NW cor. brick sign	N40°E 116.94'
		NW cor. fnd. to hse.	S80°E 67.28'

The selected location is accepted by me and is generally accepted by professional surveyors as the best available evidence of the position of the original corner.

C. Description of monument for corner and accessories established to perpetuate locating the position of the corner:

E-10 Standard Kent County Monument			
KC Remon. tag & nail S. side P. Pole	N60°W	48.43'	
KC Remon. tag & nail N. side Guy Pole	N60°E	48.96'	
SE cor. brick garage hse. #4785	N55°W	120.92'	
NE cor. brick hse. #4785	N40°W	165.61'	
NE cor. garage siding	S60°W	119.49'	
NW cor. brick sign	N40°E	116.91'	
NW cor. fnd. to hse.	S80°E	67.19'	

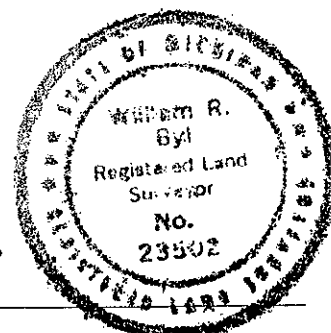

Signed by Wm R. Byl
Surveyor's Michigan License No. 23502

Date 11/27/94