

**SURVEY & REMONUMENTATION**

APR 27 1995

KENT COUNTY REMONUMENTATION

STATE OF MICHIGAN  
COUNTY OF KENT  
RECEIVED FOR RECORD

COMMISSION

LAND CORNER RECORDATION CERTIFICATE  
Filing Requirement of Act 74, Mich. P.A. 1970

DEC -5 AM 8:57

For corners in  
KENT COUNTY

	Located In:	Corner Code #
1. Public Land Survey	T 6N R 11W	E-13
	T R	
	T R	
	T R	
2. Property Controlling in Section	S T R	
	S T R	
3. Miscellaneous Property in Sec.	S T R	
	S T R	

*W. J. Bond*  
REG. OF DEEDS

7644

Register of Deeds Stamp & File Number

4. Lot No. \_\_\_\_\_, Recorded Plat \_\_\_\_\_  
5. Private Claims \_\_\_\_\_

	A	B	C	D	E	F	G	H	I	J	K	L	M
2	6	5	4	3	2	1							
3													
4	7	8	9	10	11	12							
5													
6	18	17	16	15	14	13							
7													
8	19	20	21	22	23	24							
9													
10	30	29	28	27	26	25							
11													
12	31	32	33	34	35	36							
13													

I, William R. Byl, in a field survey on Oct. 3, 19 94, do hereby certify that under requirements of P.A. 74, Michigan P.A. of 1970, the corner points mentioned in lines 1 and 2 above were in conformance with regulations and rules therefore as required in the current manual of survey instructions of the United States Department of the Interior, Bureau of Land Management or by a decree of a Court of Law and/or that the corner points mentioned in lines 3, 4 and 5 above were in conformance with the rules of the Michigan Board of Land Surveyors or by a Decree of a Court of Law; established, re-established, monumented, re-monumented, recovered, found as expressed below:

**NOTE: Not more than 4 corners, all in the same town and range, may be recorded on this certificate.**

A. Description of original monument and accessories and/or subsequent restoration:

E-13	1831	GLO	Mullett	Set Post
		Kent Co. Wit.		Iron in mon. box
	1983	LCRC #3223	Bonnema	1/2" Iron in mon. box
	1983	LCRC #3479	Byl	Set Kent County Monument in mon. box
	1985	LCRC #4292	Meyer	Reset Kent County Monument after const.
	1992	LCRC #6523	Bueche	Kent County Monument

P.A. 345 1990 KENT COUNTY

PEER APPROVED 12/1/94  
CHAIRMAN *Harry Huber*

The position of this corner was previously approved by the Kent County Remonumentation Peer Group, monumented by William R. Byl on 7/21/83 and was recorded per LCRC #3479

B. Description of corner evidence found and/or method applied in restoring or reestablishing corner:


E-13 Found standard Kent Co. Mon. (Harrison) per witnesses from above LCRC as set by Allan L. Meyer at the same location as set by William R. Byl in 1983 in place of the 1/2" Iron Pipe he found inside a mon. box. Said Iron checks with Kent Co. Wit. and LCRC #3223.

LCRC #3479		LCRC #6523
Nail & tag CP Pole	S50°E 71.11'	SE cor. conc. for sign N40°W 101.09'
Nail & tag 15" Elm	N45°E 96.06'	SE cor. brick for sign S30°W 86.02'
Nail & tag CP & MBT Pole	N30°W 74.85'	N & E edge of walks N45°E 66.92'
Nail & tag Guy Pole	S40°W 42.20'	On C/L bit. E-W, C/L bit. N. is E. 7' m/1
NE cor. 5-5-11 (KC Mon.) East	11.78'	C/L bit. S. is W. 4'
		KC Mon. NE cor. 5-5-11 East 11.78'

The selected location is accepted by me and is generally accepted by professional surveyors as the best available evidence of the position of the original corner.

C. Description of monument for corner and accessories established to perpetuate locating the position of the corner:

E-13 Standard Kent County Monument	
S'ly cor. conc. for sign	N40°W 101.13'
SE cor. brick for sign	S30°W 86.02'
N & E edge of walks	N45°E 66.92'
SW side 10" dia. Michcon vent pipe	S55°E 77.48'
Nail (no tag) E. side-Power Pole	S10°W 188.87'
Top C/L of hydrant	N25°W 89.57'
KC Mon. @ NE cor. Sec. 5, T5N, R11W	N90°E 11.78'
On C/L bit. E-W, C/L bit. N. is E. 7' m/1, C/L bit. S. is W. 4'	

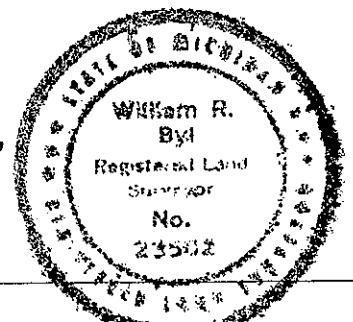

Signed by *W. R. Byl*  
Surveyor's Michigan License No. 23502

Date 11/27/94