

JAN 24 1996

\$7.00
\$2.00

COMMISSION

KENT COUNTY REMONUMENTATION

LAND CORNER RECORDATION CERTIFICATE
Filing Requirement of Act 74, Mich. P.A. 1970

For corners in
KENT COUNTY
(County)

Located In:

Corner Code #

1. Public Land Survey	T	6N	R	11W	F-2
	T		R		
	T		R		
	T		R		
2. Property Controlling in Section	S		T		R
	S		T		R
3. Miscellaneous Property in Section	S		T		R
	S		T		R

REG. OF DEEDS

Luci Stand

95 DEC 20 AM 8:38

STATE OF MICHIGAN
COUNTY OF KENT
RECEIVED FOR RECORD

8798

Register of Deeds Stamp & File Number

4. Lot No. _____, Recorded Plat _____
5. Private Claims _____

A	B	C	D	E	F	G	H	I	J	K	L	M
2	6	5			4		3		2		1	
3												
4	7	8			9		10		11		12	
5												
6	18	17			16		15		14		13	
7												
8	19	20			21		22		23		24	
9												
10	30	29			28		27		26		25	
11												
12	31	32			33		34		35		36	
13												

I, Kirk Breitels, in a field survey on Nov. 17, 1994, do hereby certify that under requirements of P.A. 74, Michigan P.A. of 1970, the corner points mentioned in lines 1 and 2 above were in conformance with regulations and rules therefore as required in the current manual of survey instructions of the United States Department of the Interior, Bureau of Land Management or by a decree of a Court of Law and/or that the corner points mentioned in lines 3, 4 and 5 above were in conformance with the rules of the Michigan Board of Professional Surveyors or by a Decree of a Court of Law; established, re-established, monumented, re-monumented, recovered, found as expressed below:

NOTE: Not more than 4 corners, all in the same town and range, may be recorded on this certificate.

A. Description of original monument and accessories and/or subsequent restoration:

F-2	1831	GL0	Not Set
	1876	D. Skiels	Set Stake & stones
	1892-1914	Williams & Works	Stake & stones
	1951-57	Williams & Works	City Iron
		Kent Co. Wit.	City Iron
	1957	City of Grand Rapids	Gas Pipe in mon. box

B. Description of corner evidence found and/or method applied in restoring or reestablishing corner:

F-2 Found 3/4" x 30" Iron Pipe in mon. box. No witnesses remain from any source. Said Iron Pipe in mon. box is 0.5' S. & 8.4' E. from intersection of 1/4 lines. Said Iron Pipe in mon. box fits adjoining plats and measurements of others.

The 3/4" Iron Pipe in mon. box is accepted by me and is generally accepted by professional surveyors as the best available evidence of the position of the corner.


P.A. 345 1990 KENT COUNTY

PEER APPROVED 11/17/94

CHAIRMAN Harry Huber

C. Description of monument for corner and accessories established to perpetuate locating the position of the corner:

F-2	Set Standard Kent County Monument in Mon. Box in place of the 3/4" Iron Pipe.		
	Rerod at NW corner of curb (near back walks)	S00°W	33.08'
	NW corner of CB header	S45°W	62.10'
	Set Nail & KC Remon. tag N. side 24" Sycamore	N60°W	49.97'
	Set Nail & KC Remon. tag N. side P. Pole	N75°E	79.05'
	SW corner of concrete sign foundation	N35°E	54.44'
	Set Nail & KC Remon. tag N. side 15" Sycamore	S65°E	65.85'

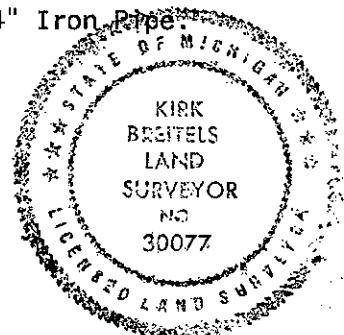

Signed by Kirk Breitels

Date 12/11/95

Surveyor's Michigan License No. 30077