

SURVEY & REMONUMENTATION

APR 27 1995

KENT COUNTY REMONUMENTATION

STATE OF MICHIGAN
COUNTY OF KENT
RECEIVED FOR RECORD

COMMISSION LAND CORNER RECORDATION CERTIFICATE
Filing Requirement of Act 74, Mich. P.A. 1970

94 DEC -5 AM 8:57

For corners in
KENT COUNTY

W. R. Byl
REG. OF DEEDS

(County)	Located In:	Corner Code #
1. Public Land Survey	T <u>6N</u> R <u>11W</u>	<u>F-7</u>
	T _____ R _____	_____
	T _____ R _____	_____
	T _____ R _____	_____
2. Property Controlling in Section	S _____ T _____ R _____	_____
	S _____ T _____ R _____	_____
3. Miscellaneous Property in Sec.	S _____ T _____ R _____	_____
	S _____ T _____ R _____	_____

7648
Register of Deeds Stamp & File Number

4. Lot No. _____, Recorded Plat _____
5. Private Claims _____

	A	B	C	D	E	F	G	H	I	J	K	L	M
2	6	5	4	3	2								
3													
4	7	8	9	10	11	12							
5													
6	18	17	16	15	14	13							
7													
8	19	20	21	22	23	24							
9													
10	30	29	28	27	26	25							
11													
12	31	32	33	34	35	36							
13													

I, William R. Byl, in a field survey on Sept. 16, 19 94, do hereby certify that under requirements of P.A. 74, Michigan P.A. of 1970, the corner points mentioned in lines 1 and 2 above were in conformance with regulations and rules therefore as required in the current manual of survey instructions of the United States Department of the Interior, Bureau of Land Management or by a decree of a Court of Law and/or that the corner points mentioned in lines 3, 4 and 5 above were in conformance with the rules of the Michigan Board of Land Surveyors or by a Decree of a Court of Law; established, re-established, monumented, re-monumented, recovered, found as expressed below:

NOTE: Not more than 4 corners, all in the same town and range, may be recorded on this certificate.

A. Description of original monument and accessories and/or subsequent restoration:

F-7	1831	GLO	Mullett	Set Post
		Kent Co. Wit.		Iron at fence cor.
	1983	LCRC #3319	Tobin	Set Kent County Monument
	1992	LCRC #6526	Bueche	Kent County Monument

The position of this corner was previously approved by the Kent County Remonumentation Peer Group, monumented by Douglas J. Tobin on 5/21/82 and was recorded per LCRC #3319

P.A. 345 1990 KENT COUNTY
PEER APPROVED 12/1/94
CHAIRMAN *Harry Huber*

B. Description of corner evidence found and/or method applied in restoring or reestablishing corner:

F-7 Found standard Kent Co. Mon. (Harrison) per witnesses from above LCRC as set by Douglas J. Tobin in place of the Concrete Monument he found. Said Concrete Monument checks with Kent Co. Wit. and adjoining plats.

LCRC #3319

KC tag & nail E. side 35" Ash	S05°E	22.75'
KC tag & nail SW side 35" Ash	S45°E	17.35'
KC tag & nail S. side 12" Basswood East		30.00'
SW corner foundation to House	N15°E	40.55'

LCRC #6526


same witnesses as LCRC #3319

The selected location is accepted by me and is generally accepted by professional surveyors as the best available evidence of the position of the original corner.

C. Description of monument for corner and accessories established to perpetuate locating the position of the corner:

F-7 Standard Kent County Monument

New KC Remon. tag & nail S. side 20" Basswood	S90°E	30.00'
SW corner foundation to House	N15°E	40.55'
Set KC Remon. tag & nail N. side 15" Maple	S55°E	26.41'
SW corner conc. step to enclosed porch	N65°E	29.04'
E. face of wood fence post	West	0.58'

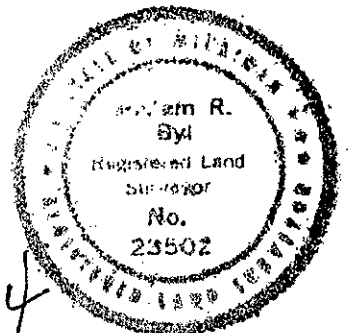

Signed by *W. R. Byl* Date 11/27/94
Surveyor's Michigan License No. 23502