SURVEY & REMONUMENTATION

APR 27 1995

COMMISSION

KENT COUNTY REMONUMENTATION

STATE OF MICHIGAN
COUNTY OF KENT
RECEIVED FOR RECORD
94 DEC -5 AM 8:57
REG. OF DEEDS

LAND CORNER RECORDATION CERTIFICATE

Filing Requirement of Act 74, Mich. P.A. 1970

For corners in KENT COUNTY (County)

	Located In:	Corner Code #
1. Public Land Survey	T 6N R 11W	F-9
	T ___ R ___	
	T ___ R ___	
	T ___ R ___	
2. Property Controlling	S ___ T ___ R ___	
in Section	S ___ T ___ R ___	
3. Miscellaneous	S ___ T ___ R ___	
Property in Sec.	S ___ T ___ R ___	

7649

Register of Deeds Stamp & File Number

4. Lot No. _____ , Recorded Plat _____
5. Private Claims _____

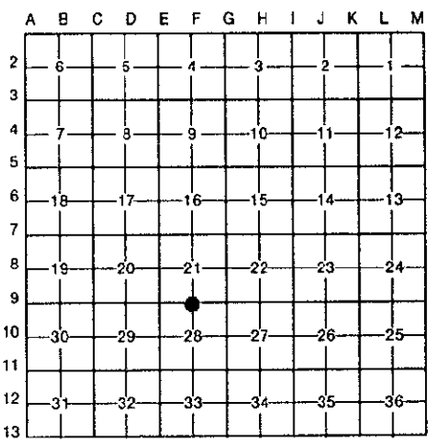

I, William R. Byl, in a field survey on Sept. 13, 19 94, do hereby certify that under requirements of P.A. 74, Michigan P.A. of 1970, the corner points mentioned in lines 1 and 2 above were in conformance with regulations and rules therefore as required in the current manual of survey instructions of the United States Department of the Interior, Bureau of Land Management or by a decree of a Court of Law and/or that the corner points mentioned in lines 3, 4 and 5 above were in conformance with the rules of the Michigan Board of Land Surveyors or by a Decree of a Court of Law; established, re-established, monumented, re-monumented, recovered, found as expressed below:

NOTE: Not more than 4 corners, all in the same town and range, may be recorded on this certificate.

P.A. 345 1990 KENT COUNTY
PEER APPROVED 12/1/94
CHAIRMAN

A. Description of original monument and accessories and/or subsequent restoration:

F-9	1831	GLO	Mullett	Set Post
	1962	Kent Co. Wit.		Mon. Box
	1974	LCRC #621	South	3/4" Pipe in mon. box
	1975	LCRC #857	Nederveld	Iron in mon. box
	1981	LCRC #2480	Hackbardt	Set Kent County Monument in mon. box
	1991	LCRC #5777	Bueche	Cut "X" on N. face curb after const.
	1992	LCRC #6527	Bueche	"X" on N. face curb

The position of this corner was previously approved by the Kent County Remonumentation Peer Group, monumented by Glen S. Hackbardt on 9/22/81 and was recorded per LCRC #2480

B. Description of corner evidence found and/or method applied in restoring or reestablishing corner:

F-9 Found "X" on N. face of curb in gutter of S. curb for W. bound lane 44th St. per witnesses from above LCRC as set by John C. Bueche at the same location as a Kent Co. Mon. set by Glen S. Hackbardt in 1981 in place of the 3/4" Iron that he found inside a mon. box. Said 3/4" Iron in mon. box checks with Kent Co. Wit. and LCRC's #621 & #857.

LCRC #2480			LCRC #6527		
C/L hydrant	N15°E	27.86'	Nail & KC Remon. tag curb joint	East	75.61'
NE cor. CB header	N10°W	22.48'	C/L manhole	West	14.65'
C/L Manhole	West	14.65'	Face 18" dia. conc. base to light	S02°W	72.79'
Face of 18" dia. conc. base to light	S02°W	72.79'	"X" cut in NE cor. brick planter	S60°W	105.44'
			NW cor. brick pillar to bldg. #1996	S05°E	151.42'
			C/L hydrant	N25°E	46.34'

The selected location is accepted by me and is generally accepted by professional surveyors as the best available evidence of the position of the original corner.

C. Description of monument for corner and accessories established to perpetuate locating the position of the corner:

F-9 "X" cut on N. face of curb in gutter of S. curb for W. bound lane 44th St.

Nail & KC Remon. tag in curb joint	S90°E	75.61'
C/L manhole	S90°W	14.73'
"X" cut in NE cor. brick planter	S60°W	105.44'
NW cor. brick pillar to bldg. #1996	S05°E	151.34'
C/L hydrant	N25°E	46.40'
NW cor. CB header	S35°W	83.81'
Set Nail & KC remon. tag W. side Util. Pole	S25°E	46.72'

STATE OF MICHIGAN
William R. Byl
Registered Land Surveyor
No. 23502
REGISTERED 1979 TERRITORY

Signed by _____ Date 11/27/94

Surveyor's Michigan License No. 23502

FORM APPROVED BY MICHIGAN STATE BOARD OF LAND SURVEYORS, JAN. 28, 1971
REVISED MAY 14, 1975
REVISED JAN., 1983