

SURVEY & REMONUMENTATION

APR 27 1995 KENT COUNTY REMONUMENTATION

COMMISSION AND CORNER RECORDATION CERTIFICATE

Filing Requirement of Act 74, Mich. P.A. 1970

STATE OF MICHIGAN
COUNTY OF KENT
RECEIVED FOR RECORD

94 DEC -5 AM 8:57

For corners in
KENT COUNTY
(County)

Located In: Corner Code #

- | | | | |
|---------------------------------------|--------------------------|-------------|--|
| 1. Public Land Survey | T <u>6N</u> R <u>11W</u> | <u>F-13</u> | |
| | T _____ R _____ | _____ | |
| | T _____ R _____ | _____ | |
| | T _____ R _____ | _____ | |
| 2. Property Controlling in Section | S _____ T _____ R _____ | _____ | |
| | S _____ T _____ R _____ | _____ | |
| 3. Miscellaneous Property in Sec. | S _____ T _____ R _____ | _____ | |
| | S _____ T _____ R _____ | _____ | |
| 4. Lot No. _____, Recorded Plat _____ | | | |
| 5. Private Claims _____ | | | |

W. R. Byl
REG. OF DEEDS

7651

Register of Deeds Stamp & File Number

I, William R. Byl, in a field survey on July 7, 19 94, do hereby certify that under requirements of P.A. 74, Michigan P.A. of 1970, the corner points mentioned in lines 1 and 2 above were in conformance with regulations and rules therefore as required in the current manual of survey instructions of the United States Department of the Interior, Bureau of Land Management or by a decree of a Court of Law and/or that the corner points mentioned in lines 3, 4 and 5 above were in conformance with the rules of the Michigan Board of Land Surveyors or by a Decree of a Court of Law; established, re-established, monumented, re-monumented, recovered, found as expressed below:

NOTE: Not more than 4 corners, all in the same town and range, may be recorded on this certificate.

	A	B	C	D	E	F	G	H	I	J	K	L	M
2	6	5	4	3	2	1							
3													
4	7	8	9	10	11	12							
5													
6	18	17	16	15	14	13							
7													
8	19	20	21	22	23	24							
9													
10	30	29	28	27	26	25							
11													
12	31	32	33	34	35	36							
13													

A. Description of original monument and accessories and/or subsequent restoration:

F-13	1831	GLO	Mullett	Set Post
	1943	Kent Co. Wit.		Iron
	1983	LCRC #3224	Bonnema	3/4" Iron in mon. box
	1983	LCRC #3480	Byl	Set Kent County Monument in mon. box
	1992	LCRC #6529	Bueche	Kent County Monument

P.A. 345 1990 KENT COUNTY

PEER APPROVED 12/1/94
CHAIRMAN *Harry Stuber*

The position of this corner was previously approved by the Kent County Remonumentation Peer Group, monumented by William R. Byl on 7/21/83 and was recorded per LCRC #3480

B. Description of corner evidence found and/or method applied in restoring or reestablishing corner:

F-13 Found standard Kent Co. Mon. (Harrison) per witnesses from above LCRC as set by William R. Byl in place of the 3/4" Iron Pipe he found inside a mon. box. Said Iron Pipe checks with Kent Co. Wit. and LCRC #3224


<u>LCRC #3480</u>	<u>LCRC #6529</u>	
Nail & tag 10" Elm	S25°W 31.56'	C/L top of hydrant
Nail & tag MBT Pole	N45°E 67.93'	KC Remon. tag & nail E. Side PP
Nail & tag P. Pole	N50°W 82.96'	SW cor. fnd. to garage hse. #1995
C/L top of hydrant	N55°W 78.11'	SW cor. brick hse. #2009
N 1/4 cor. Sec. 4-5-11 (KC Mon.)	N. edge walk & E. edge dr. to hse.	N65°E 140.19'
East 11.22'	NW cor. conc. gutter pan	S80°E 161.23'
	KC Mon. N 1/4 cor. 4-5-11	East 11.22'
	C/L power line N-S is W. 63'; on C/L bit. E-W	

The selected location is accepted by me and is generally accepted by professional surveyors as the best available evidence of the position of the original corner.

C. Description of monument for corner and accessories established to perpetuate localizing the position of the corner:

F-13 Standard Kent County Monument
C/L top of hydrant
KC Remon. tag & nail E. Side P. Pole (E'ly pole)
SW cor. fnd. to garage hse. #1995
SW cor. brick hse. #2009
N. edge walk & E. edge dr. to hse. #2011
NW cor. conc. gutter pan
KC Mon. at N 1/4 cor. Sec. 4, T5N, R11W
C/L power line N-S is W. 63', on C/L bit. E-W

N55°W	78.11'
S35°W	97.47'
N20°W	102.56'
N30°E	128.46'
N65°E	140.29'
S80°E	161.20'
S90°E	11.22'

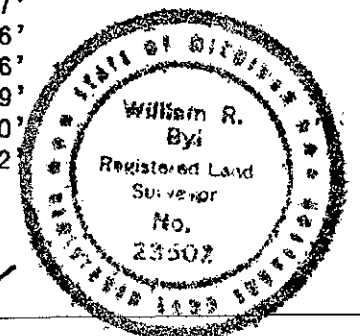

Signed by *W. R. Byl*
Surveyor's Michigan License No. 23502

Date 11/27/94